IREDELL COUNTY HEALTH DEPARTMENT

Statesville Office (704) 878-5305 Mooresville Office (704) 660-3625 PERMIT # 20425O

IMPROVEMENT PERMIT / AUTHORIZATION TO CONSTRUCT / OPERATION PERMIT / EXISTING SYSTEM

PIN # 4721806188

APPLICANT: Thomas Loftin APPLICANT ADDRESS: 181 Maple View Dr Troutman

SITE ADDRESS: 244 Hicks Creek Rd Troutman NC PHONE: 704-902-1330 ALT. PHONE: N/A

SITE DIRECTIONS: Old Mountain to E Monbo Rd (L) on Hicks Creek Lot on right


SUBDIVISION: N/A SECTION: N/A LOT # N/A LOT AREA: 2.791ac DESIGN FLOW: 480 L.T.A.R.: 0.3

Septic Tank	1000	(gal)	STB	794	Date	2-9-15	☒ New System	☐ Repair	☐ Expansion	System Type: I II III IV V VI	
Pump Tank	N/A	(gal)	PT	N/A	Date	N/A	System Description:	25% Reduction			
Pump Make	N/A	Model	Poly/ok		Serial #	PL-68	Repair System Description:	50% Reduction			
# Nitrification Fields	1	# Lines	4		Linear Ft:	400	Maintenance Agreement Required:	☐ YES	☒ NO		
Trench Width	36"	Max. Trench Bottom Depth	36"		Gravel Depth	N/A	☑ GRAVITY	☐ PRESSURE			


☒ Residence	No. Bedrooms	4	Water Supply	
☐ Business	No. Persons	8	☒ Private	
☐ Other	No. Employees		☐ Public	
☐ Slab	☒ Crawl Space		☐ Community	
☐ Basement w/plumbing			☐ Basement w/o plumbing	

Comments / Conditions: Install 25% Reduction on contour. Trench bottom minimum 36" to maintain under manipulated soil.

INITIAL SITE SKETCH

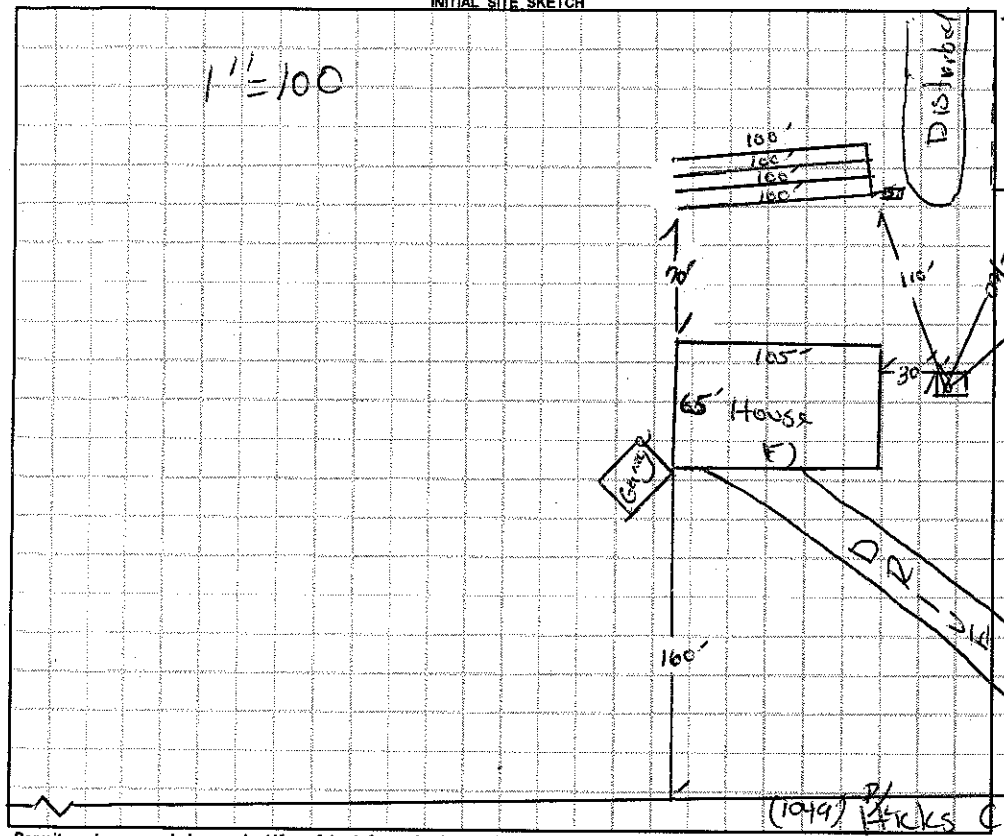

AS BUILT SKETCH

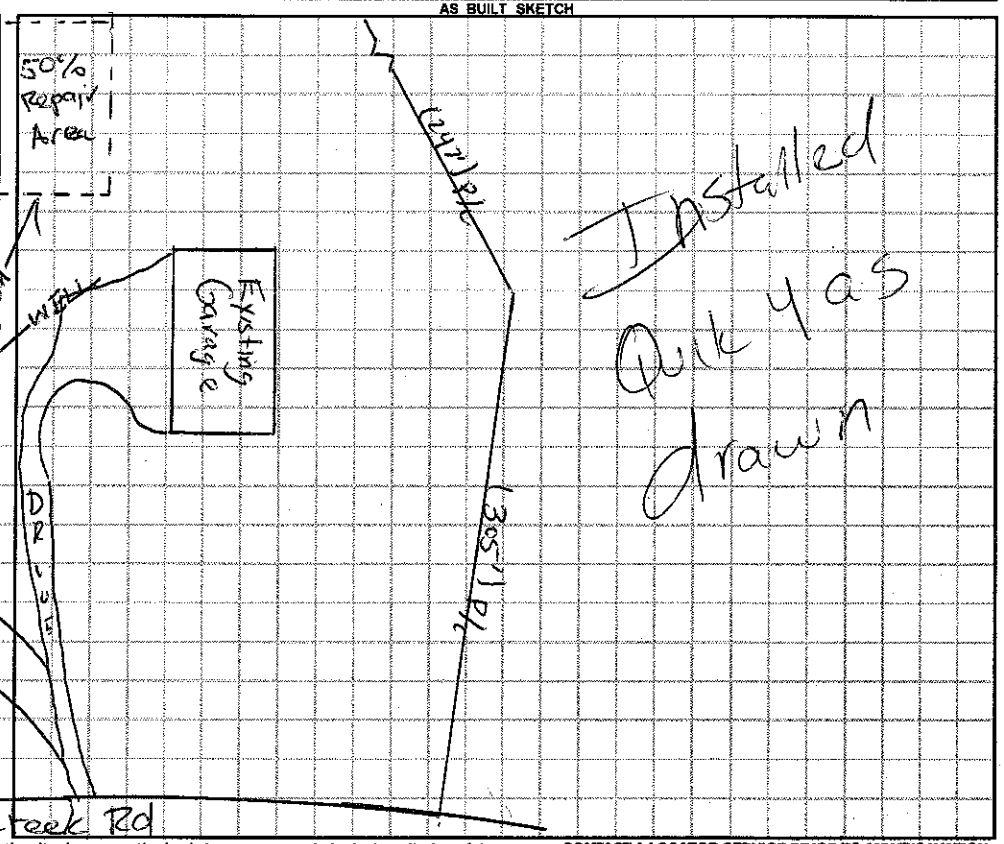

Permit can be suspended or revoked if any false information is supplied toward securing the permit / any unauthorized changes are made to the site / any unauthorized changes are made in the installation of the system. **CONTACT A LOCATOR SERVICE PRIOR TO ANY EXCAVATION**

☐ **IMPROVEMENT PERMIT** *with plat valid without expiration.* ☒ **IMPROVEMENT PERMIT** *with site plan valid for 60 mos.* ☒ **AUTHORIZATION TO CONSTRUCT** *valid for period equal to IMPROVEMENT PERMIT--not to exceed 60 mo.*

Owner / Applicant Signature: Thomas Loftin Date: 3-7-15 Installed by: Richard Abernathy

IMPROVEMENT PERMIT by: Debbie Hunt Date: 08/06/14 OPERATION PERMIT by: Debbie Hunt Date: 03/12/15

AUTHORIZATION TO CONSTRUCT by: Debbie Hunt Date: 08/12/14 Existing System Inspected by: Date:

Health Dept. Copy - WHITE Applicant (Final Approval) - YELLOW Applicant (Conditional Approval) - PINK