IREDELL COUNTY HEALTH DEPARTMENT

STATESVILLE 704-878-5305 (or) MOORESVILLE 704-664-5281

IMPROVEMENT PERMIT / AUTHORIZATION TO CONSTRUCT / OPERATION PERMIT / EXISTING SYSTEM INSPECTION

PERMIT # 156973 PIN # 4720-99-1491 DATE 25 June 09

OWNER or APPLICANT Dustin Coffin PHONE: Business Home: (704) 902-1330

OWNER or APPLICANT ADDRESS 181 Maple View Dr. Troutman

LOCATION / DIRECTIONS East Mondo Rd TL Hicks Creek Rd. 1.5 mi Rt on RT.

SUBDIVISION BLOCK / SECTION LOT # LOT AREA 1 Ac± DESIGN FLOW ~~360~~ 120 gpd L.T.A.R. 0.3 gpd

Septic Tank Exist. Gallons: STB Date

Pump Tank Gallons: P T Date

Pump Make Model Serial #

Nitrification Field No Fields 1 No Lines 42 Linear Feet 120

Trench Width 36" Max. Trench Bottom Depth 36" Gravel Depth

☐ New System ☐ Repair ☑ Expansion System Type I II III IV V VI

System Description: 25% Reduction

Repair System Description:

Maintenance Agreement Required ☐ YES ☑ NO

☑ GRAVITY ☐ PRESSURE

☑ Residence No. Bedrooms 3

☐ Business No. Persons

☐ Other No. Employees

☐ Slab ☑ Crawl Space

☐ Basement w/plumbing ☐ Basement w/o plumbing

Water Supply: ☑ Private ☐ Public ☐ Community

Comments / Conditions

* Cut-off exist. lines and plan with compacted clay 10' from drop line. Add new drop box and 120 ft. with 1 25% Reduction system.

Comments / Conditions

INITIAL SITE SKETCH

Please see Attached site sketch.

AS BUILT SKETCH

Permit can be suspended or revoked if any false information is supplied toward securing the permit / any unauthorized changes are made to the site / any unauthorized changes are made in the installation of the system.

☐ *IMPROVEMENT PERMIT w / plat valid without expiration.* ☑ *IMPROVEMENT PERMIT w / site plan valid for 60 mos.* ☑ *AUTHORIZATION TO CONSTRUCT valid for period equal to IMPROVEMENT PERMIT-not to exceed 60 mo.*

Owner / Applicant Signature: Date 6-26-09

Improvement Permit by: R.S. Date 25 June 09

Authorization to Construct by: R.S. Date 25 June 09

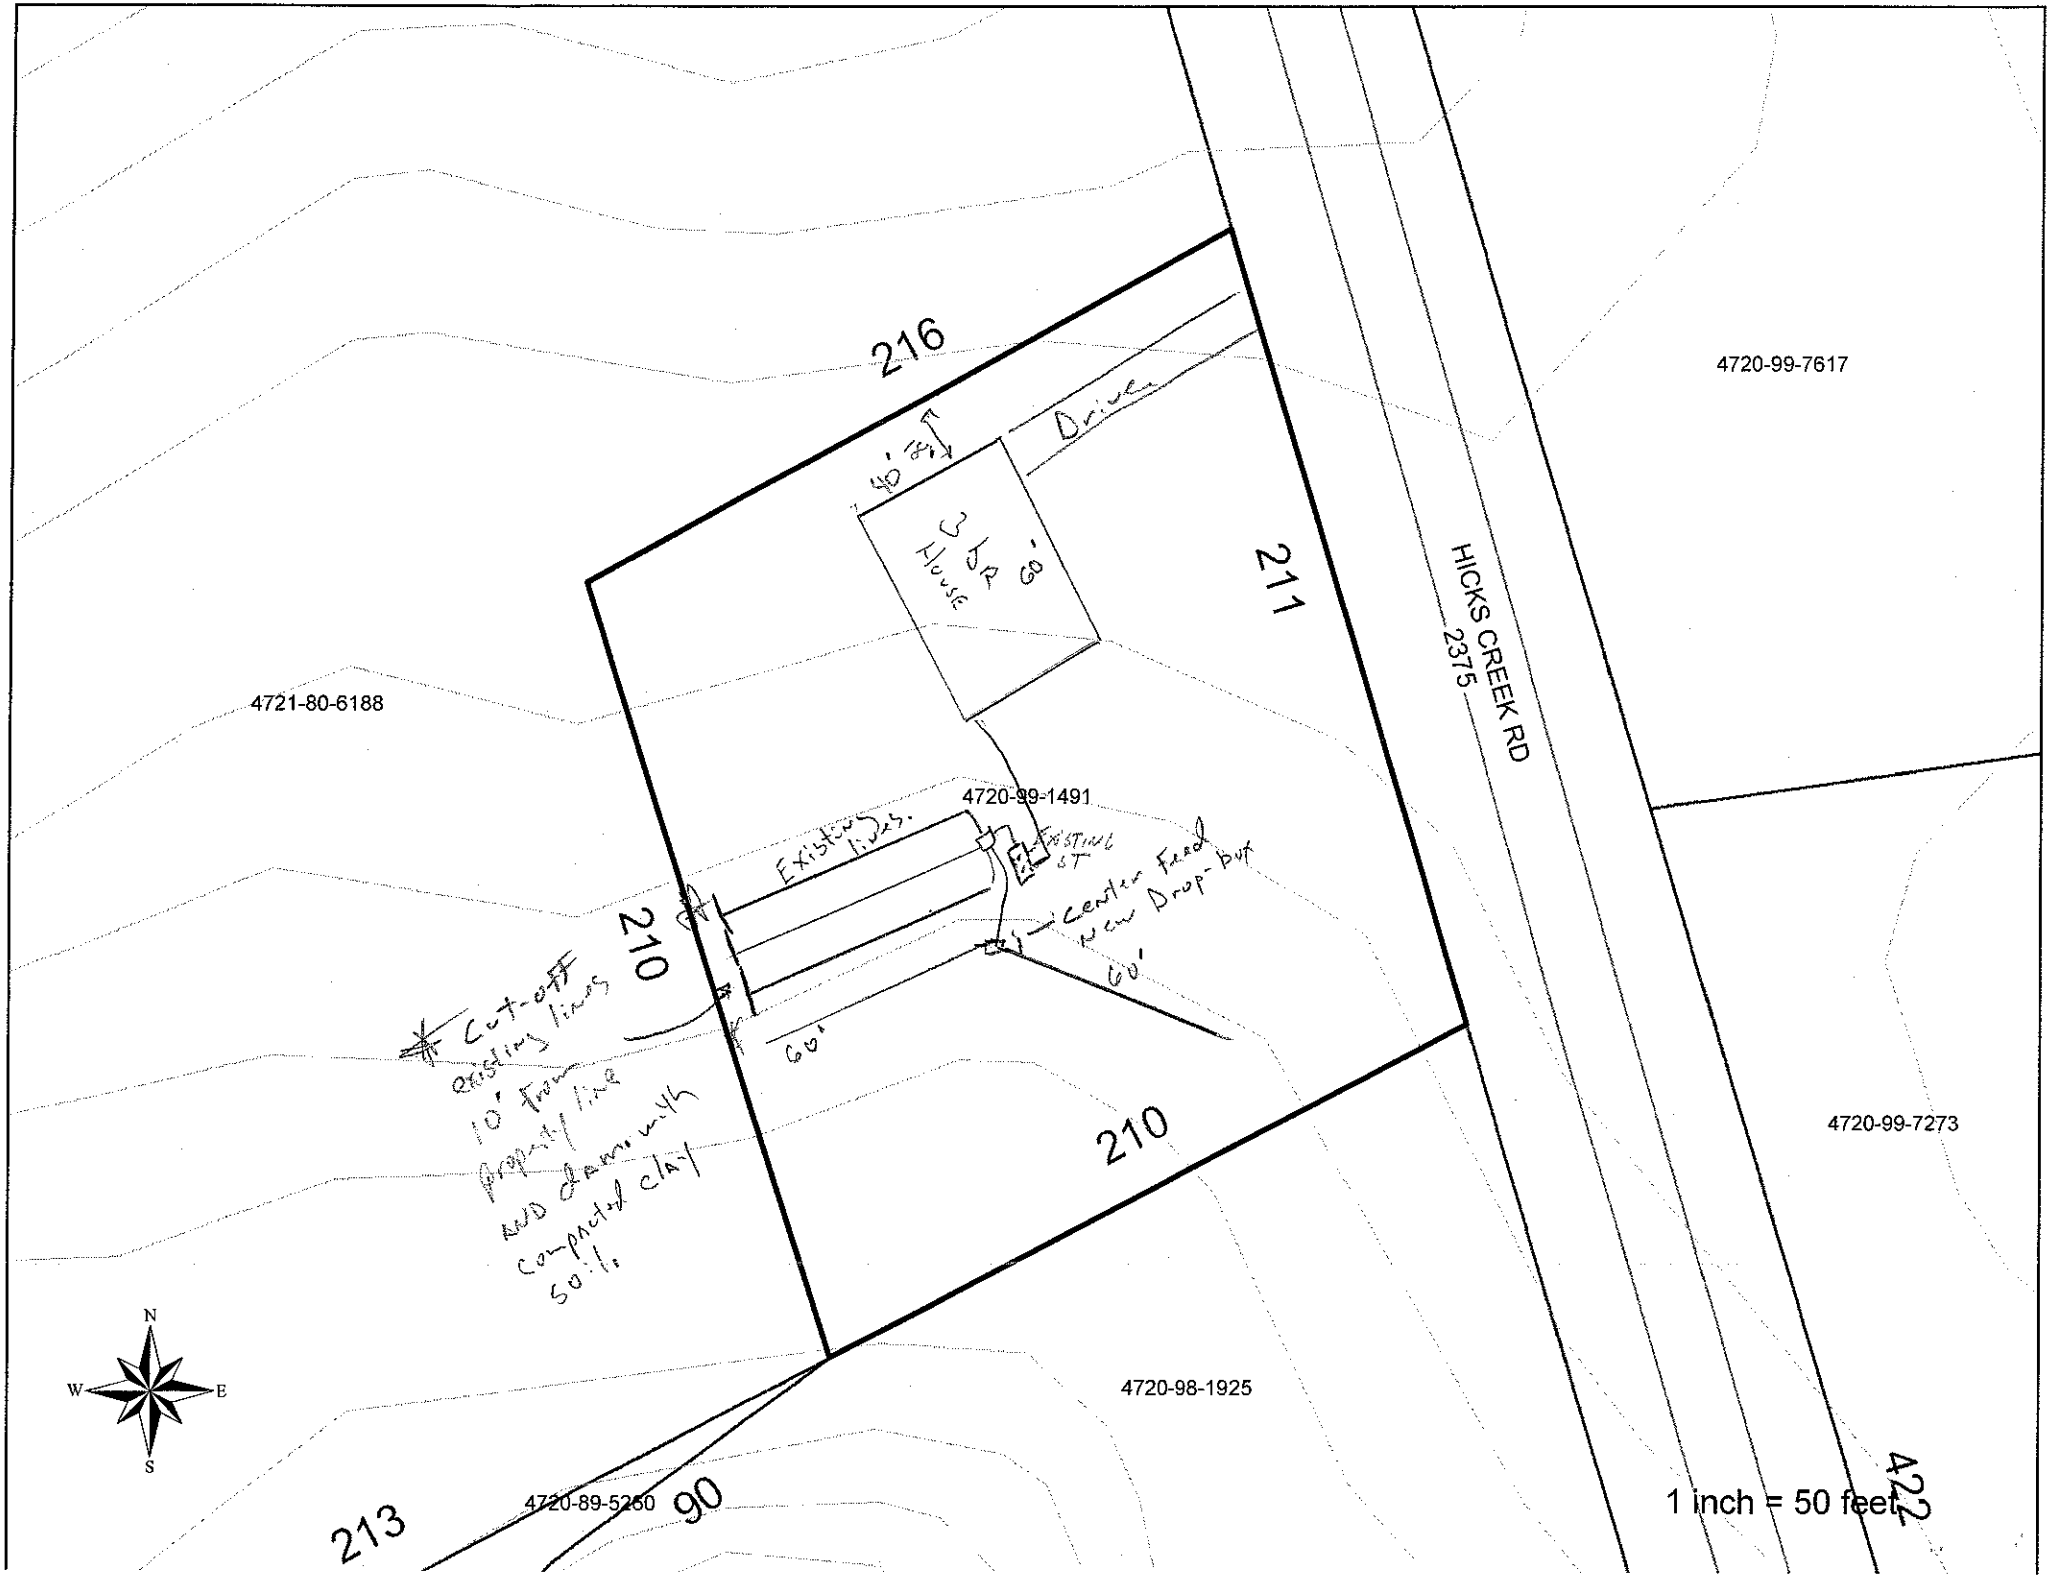
YOU SHOULD CONTACT A LOCATOR SERVICE PRIOR TO ANY EXCAVATION.

Installed by: Wes Lytle

Operation Permit by: Date: 8-11-09

Existing System Inspected by: Date:

WHITE COPY Environmental Health YELLOW COPY (Final) Owner / Applicant PINK COPY (Initial) Owner / Applicant


216
211
210
210
213
90
422
HICKS CREEK RD
2375
Drive
40'-8"
3 BR 3
House
Existing lines
Existing ST
Center feed new Drop-Box
60'
60'
Cut-off existing lines 10' from property line and clamp with compacted clay soil.
4721-80-6188
4720-99-1491
4720-99-7617
4720-99-7273
4720-98-1925
4720-89-5260
N
W
E
S
1 inch = 50 feet