IREDELL COUNTY HEALTH DEPARTMENT

STATESVILLE 704-878-5305 MOORESVILLE 704-664-5281

IMPROVEMENT PERMIT / CERTIFICATE OF COMPLETION / OPERATION PERMIT / EXISTING SYSTEM INSPECTION

PROPERTY DESCRIPTION NO. 22752 DATE 3-20-96 TAX MAP NO 39-1-B-4 Watershed: IV PA ✓No

OWNER OR CONTRACTOR ANTHONY DAY PHONE: Business 873-2547 Home 528-4830

ADDRESS 1633 EUFOLA ROAD, STATESVILLE, NC 28677

LOCATION BUFFALO SHOALS ROAD, TL EUFOLA ROAD, AT END ON LEFT

SUBDIVISION R.T. EIDSON BLOCK / SECTION LOT 4 LOT AREA 33,898 ft² SITE CLASS PS DESIGN FLOW 240 L.T.A.R 0.25 gpd/ft²

Septic Tank 1000 Gallons: STB 825 Date 12/7/95

Pump Tank Gallons: PT Date

Pump Make: Model Serial No

Nitrification Field: No Fields 1 Square Feet 960 Linear Feet 320

No Lines 4 Trench Width 36" Max Trench Bottom Depth 18-36" Gravel Depth 12"

✓New System Repair System Type I II III IV V VI

System Description: CONVENTIONAL GRAVITY

Repair System Description: CONVENTIONAL PUMP

Maintenance Agreement Required Yes ✓No

House/Mod. Home No. Bedrooms 2

✓Mobile Home No. Bathrooms 2

Business No. Employees

Other


Slab ✓Crawl Space Basement w/plumbing Basement wo/plumbing

Water Supply ✓Individual Community Public WELL NEXT DOOR


Comments: ① INSTALL FOUR 80' LINES ON CONTOUR AS SHOWN, ② USE THREE FLOW DIVIDER TEES TO ACHIEVE EQUAL DISTRIBUTION INTO EACH OF FOUR LINES ③ KEEP SYSTEM MINIMUM 10' FROM PROPERTY LINE, 100' FROM WELL.

Comments

INITIAL SITE SKETCH

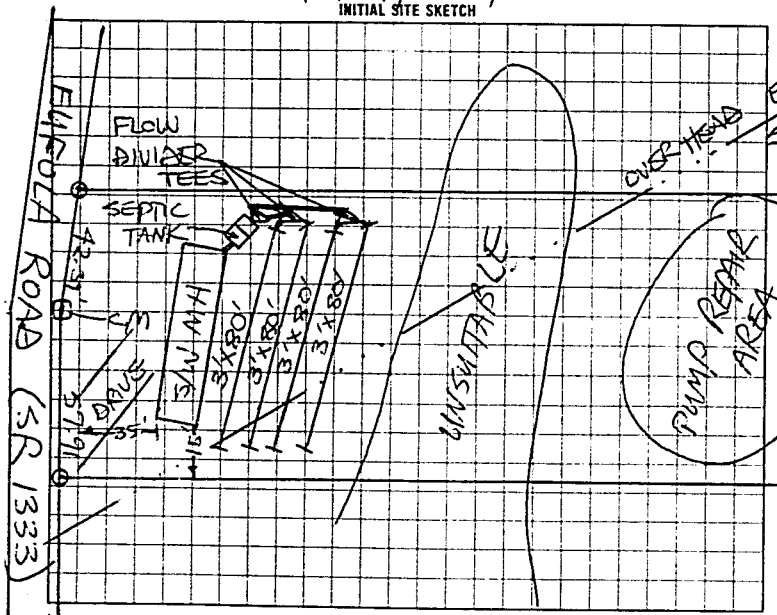

AS BUILT SKETCH

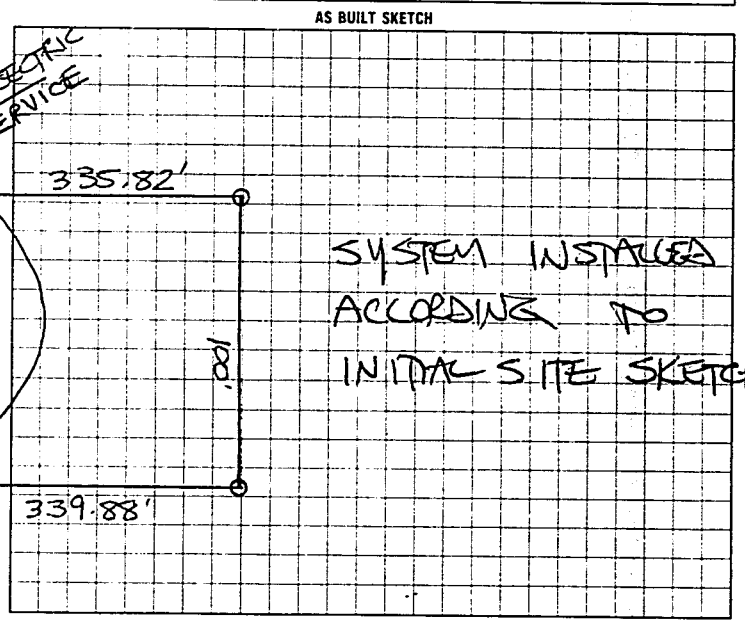

I understand that this permit can be suspended or revoked if any false information is supplied toward securing the permit/any unauthorized changes are made to the site/any unauthorized changes are made in the installation of the system

AUTHORIZATION TO CONSTRUCT IS VALID FIVE (5) YEARS FROM DATE OF ISSUANCE. IMPROVEMENT PERMIT HAS NO EXPIRATION DATE.

Signed Anthony Day

Improvement Permit by STEVE HEDRICK date 3-19-96

Authorization to Construct STEVE HEDRICK date 3-19-96

Existing System Inspection by

Installed by ERIC SWAIN

Certificate of Completion by date

Operation Permit by STEVE HEDRICK date 4-15-96

HEALTH DEPT. COPY WHITE INSPECTION COPY (FINAL) GREEN OWNER COPY (FINAL) YELLOW INSPECTION COPY (INITIAL) PINK

7 5 2 8 0 0