IREDELL COUNTY HEALTH DEPARTMENT

STATESVILLE 704-878-5305 MOORESVILLE 704-664-5281 eI

IMPROVEMENT PERMIT / AUTHORIZATION TO CONSTRUCT / OPERATION PERMIT / EXISTING SYSTEM INSPECTION

PERMIT# 121194 PIN# 4721-08-2911 DATE 7/29/04

OWNER OR CONTRACTOR Rod Morrow PHONE: Business Home

ADDRESS 186 Hosack Rd Jackson Center, PA 16133

LOCATION Buffalo Shoals Rd (2) on Buffalo Rd (2) on Amber Rd. 4th House on Right

SUBDIVISION Green Valley BLOCK / SECTION LOT 20 LOT AREA 100 x 150 SITE CLASS. PS DESIGN FLOW 360 L.T.A.R.

Septic Tank: 1,000 Gallons; STB Date

Pump Tank: Gallons; PT Date

Pump Make: Model Serial No.

Nitrification Field: No Fields 1 Square Feet 630 Linear Feet 210

No Lines 3 Trench Width 9Ft Bed Max Trench Bottom Depth 18" Gravel Depth 16"

☐ New System ☐ Repair System Type: I, (II), III, IV, V, VI

System Description: Gravity Conventional

Repair System Description:

Maintenance Agreement Required: ☐ Yes ☒ No

☐ House/Mod. Home ☒ Mobile Home ☐ Business ☐ Other


No. Bedrooms 3 No. Bathrooms No. Employees

☐ Slab ☒ Crawl Space ☐ Basement w/plumbing ☐ Basement wo/plumbing

Water Supply: ☒ Individual ☐ Public ☐ Community

Comments:/Conditions: *Towable


INITIAL SITE SKETCH

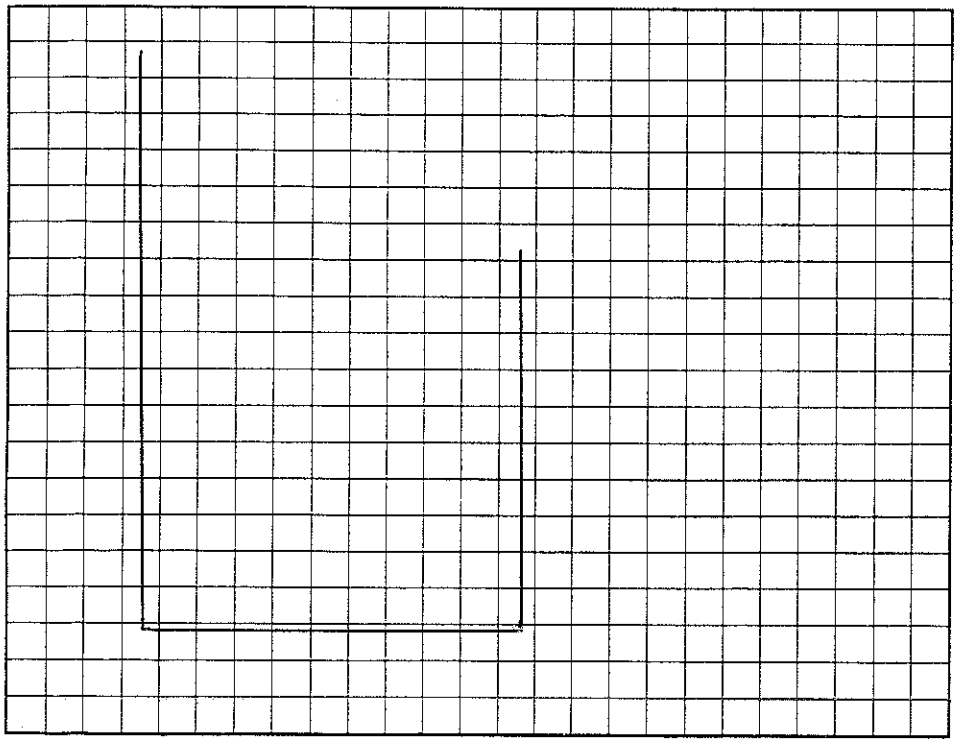

Comments:/Conditions: System Not in use at time of Inspection. Appears to be working properly. -Keep MH minimum 5ft from ST + Lines.

(Re: John Hicks 7/5/99)

AS BUILT SKETCH

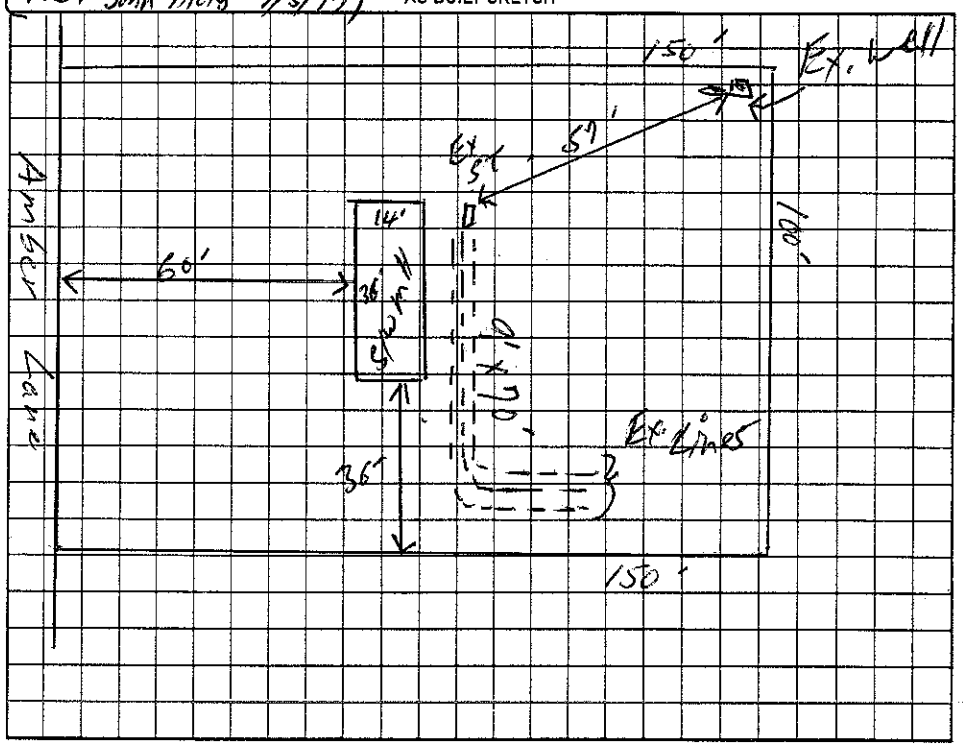

Permit can be suspended or revoked if any false information is supplied toward securing the permit/any unauthorized changes are made to the site/any unauthorized changes are made in the installation of the system. Improvement Permit with plat valid without expiration. Improvement Permit with site plan valid for sixty months. Authorization to Construct is valid for a period equal to that of Improvement Permit – not to exceed sixty months.

Signed: date Installed by:

Improvement Permit by: date Operation Permit by: date

Authorization to Construct by: date Existing System Inspection by: William C. Johnson date 7/29/04

HEALTH DEPT. COPY: WHITE OWNER COPY (FINAL): YELLOW OWNER COPY (INITIAL): PINK