IREDELL COUNTY HEALTH DEPARTMENT

Statesville Phone TR 3-7271 Mooresville Phone NO 3-1271

PERMIT TO INSTALL SEPTIC TANK

Permit No. 202 Permit Date 10-13 1972

Owner Marvin McDaniel Address Statesville NC

Installed By Alexander Septic Tank Co Address Stony Point NC


Location of Property East Buffalo Shoals Rd to Glen Lee Rest Home T.L. on Rd #1533 Bear to R. Trailer on Rt of Rd # 1429.

Tank		Capacity		Length of Lines		Fixtures	
Block	( )	1000	(✓)	225'	(✓)	No. of Baths	( )
Precast	(✓)	1250	( )	250'	( )	Dishwasher	( )
		1500	( )	Other		Garbage Grdr.	( )
		Other				Other	

NOTIFY HEALTH DEPARTMENT AT LEAST EIGHT HOURS BEFORE TANK IS TO BE INSPECTED.

Final Inspection 10-13 1972 Approved (✓) Disapproved ( )

Remarks Water from Rest Ht

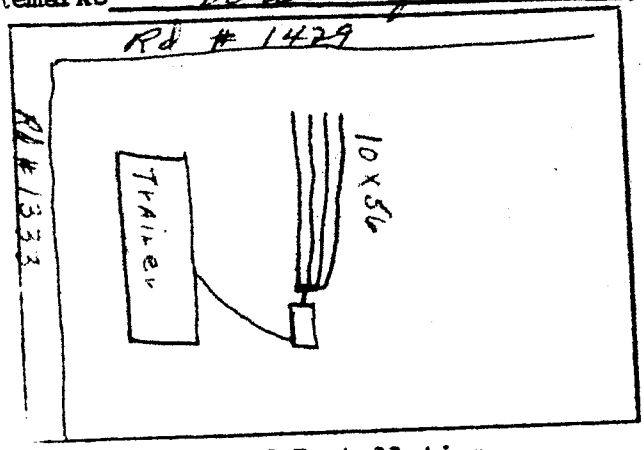

Sketch of Installation

E. A. Stevenson
Sanitarian