IREDELL COUNTY HEALTH DEPARTMENT

Statesville Office (704) 878-5305 Mooresville Office (704) 660-3625 PERMIT # 204597

IMPROVEMENT PERMIT / AUTHORIZATION TO CONSTRUCT / OPERATION PERMIT / EXISTING SYSTEM

PIN # 4721092179

APPLICANT: Brenda K. Fields APPLICANT ADDRESS: 114 Gains Ln Statesville NC

SITE ADDRESS: 114 Gains Ln Statesville NC 28677 PHONE: 704-402-3610 ALT. PHONE: 704-528-9371

SITE DIRECTIONS: Buffalo Shoals T/L on Eufola Rd T/R on Gains Rd Lot on right

SUBDIVISION: N/A SECTION: N/A LOT # N/A LOT AREA: 0.7ac DESIGN FLOW: EX L.T.A.R.: EX


Septic Tank	EX	(gal)	STB	EX	Date	EX	☐ New System ☐ Repair ☐ Expansion System Type: I / II / III IV V VI	☒ Residence	No. Bedrooms EX
Pump Tank	N/A	(gal)	PT	N/A	Date	N/A	System Description: EXisting	☐ Business	No. Persons EX
Pump Make	N/A	Model		N/A	Serial #	N/A	Repair System Description:	☐ Other	No. Employees
# Nitrification Fields	1	# Lines		EX	Linear Ft:	EX	Maintenance Agreement Required: ☐ YES ☒ NO	☐ Slab	☒ Crawl Space
Trench Width	EX	Max. Trench Bottom Depth		EX	Gravel Depth	EX	☒ GRAVITY ☐ PRESSURE	☐ Basement w/plumbing	☐ Basement w/o plumbing

Water Supply: ☒ Private ☐ Public ☐ Community

Comments / Conditions: All building foundations must be 55' from any part of STS and 525' from any well.

INITIAL SITE SKETCH

AS BUILT SKETCH

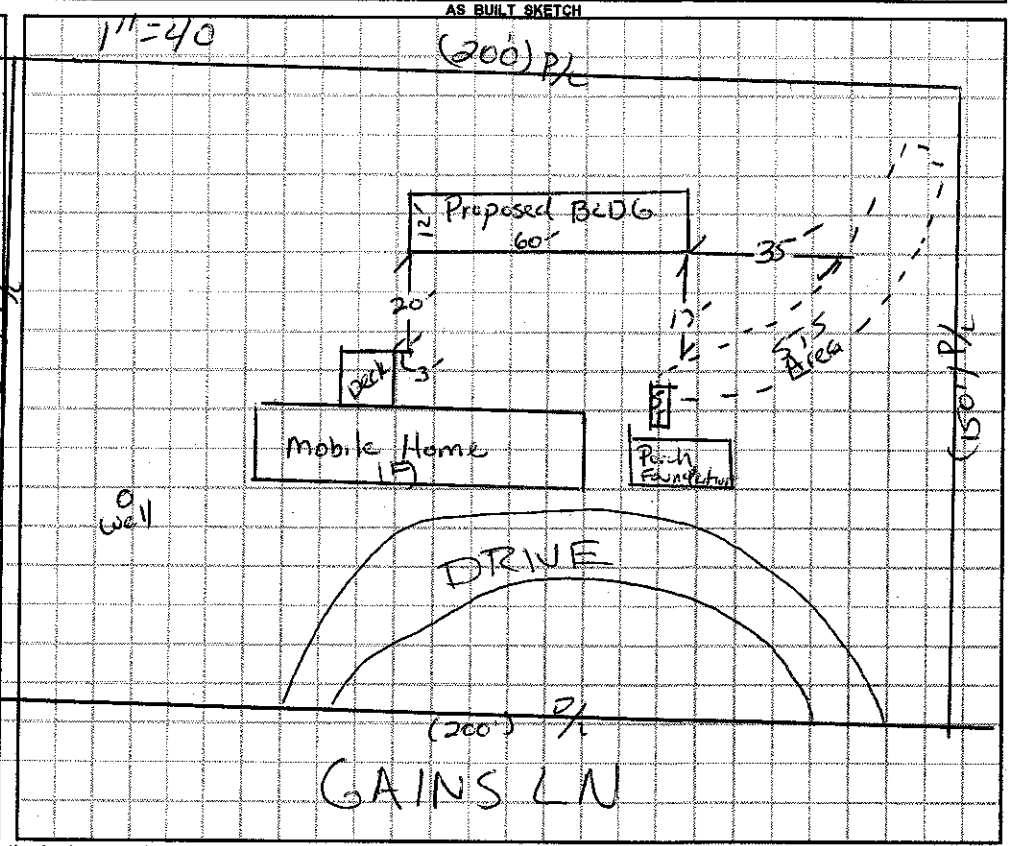

Permit can be suspended or revoked if any false information is supplied toward securing the permit / any unauthorized changes are made to the site / any unauthorized changes are made in the installation of the system. **CONTACT A LOCATOR SERVICE PRIOR TO ANY EXCAVATION**

☐ **IMPROVEMENT PERMIT** *with plat valid without expiration.* ☐ **IMPROVEMENT PERMIT** *with site plan valid for 60 mos.* ☐ **AUTHORIZATION TO CONSTRUCT** *valid for period equal to IMPROVEMENT PERMIT--not to exceed 60 mo.*

Owner / Applicant Signature: Brenda K. Fields Date: 10-10-2014 Installed by:

IMPROVEMENT PERMIT by: Date: OPERATION PERMIT by: Date:

AUTHORIZATION TO CONSTRUCT by: Date: Existing System Inspected by: Robert A Date: 07/25/14

Health Dept. Copy - WHITE Applicant (Final Approval) - YELLOW Applicant (Conditional Approval) - PINK