IREDELL COUNTY HEALTH DEPARTMENT

STATESVILLE 704-878-5305 MOORESVILLE 704-664-5281

IMPROVEMENT PERMIT / AUTHORIZATION TO CONSTRUCT / OPERATION PERMIT / EXISTING SYSTEM INSPECTION

DATE 12-19-00

PERMIT# 81859 PIN# 4721 09 4010

OWNER OR CONTRACTOR MICHAEL EVANS PHONE: Business 881-0704 Home 871-8419

ADDRESS 109 GAINS LANE, STATESVILLE, NC 28677

LOCATION BUFFALO SHOALS, TL EUFOLA RD, TR GAINS LANE, 2ND LOT ON LEFT

SUBDIVISION BLOCK / SECTION LOT LOT AREA 100'X150' SITE CLASS PS DESIGN FLOW ~~360~~ 240 L.T.A.R. 0.30 GPD/FT²

Septic Tank: 1000 Gallons: STB 1012 Date 8-23-00

Pump Tank: Gallons: PT Date

Pump Make: Model Serial No

Nitrification Field: No Fields 1 Square Feet 810 Linear Feet 270

No Lines THREE Trench Width 36" Max Trench Bottom Depth 36" Gravel Depth 12"

☑ New System ☐ Repair System Type: I (II) III IV V VI

System Description: CONVENTIONAL GRAVITY

Repair System Description: CONV. MAX FEASIBLE (.1945(c))

Maintenance Agreement Required: ☐ Yes ☑ No

☑ House/Mod. Home ☐ Mobile Home ☐ Business ☐ Other

No. Bedrooms 2 No. Bathrooms 1 No. Employees


Water Supply: ☑ Individual ☐ Public ☐ Community

☐ Slab ☑ Crawl Space ☐ Basement w/plumbing ☐ Basement wo/plumbing

Comments/Conditions: ① KEEP SYSTEM MAXIMUM FEASIBLE DISTANCE FROM WELL (60') ② KEEP SYSTEM MINIMUM FIVE (5) FEET FROM PROPERTY LINE (.1951 (c)(3))

Comments/Conditions: SYSTEM SIZED TO ACCOMODATE TWO BEDROOMS ONLY ① USED POLYLOK FILTER ② INSTALLED WITH MARKER

INITIAL SITE SKETCH

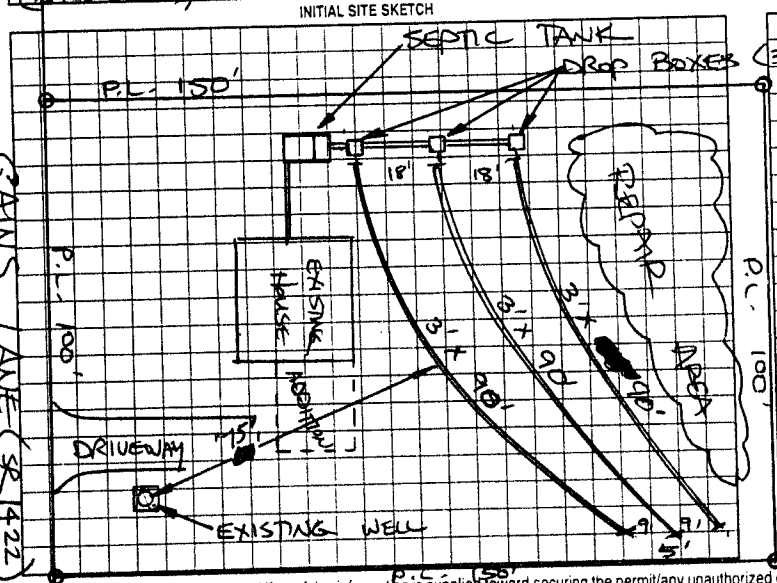

AS BUILT SKETCH

① INSTALLED AS SHOWN

Permit can be suspended or revoked if any false information is supplied toward securing the permit/any unauthorized changes are made to the site/any unauthorized changes are made in the installation of the system. Improvement Permit with plat valid without expiration. Improvement Permit with site plan valid for sixty months. Authorization to Construct is valid for a period equal to that of Improvement Permit – not to exceed sixty months.

Signed: Michael Evans date 12/19/00 Installed by: JORDAN BALLENGER

Improvement Permit by: STEVE HEDRICK date 12-19-00 Operation Permit by: [signature] date 01-16-01

Authorization to Construct by: STEVE HEDRICK date 12-19-00 Existing System Inspection by: date

HEALTH DEPT COPY WHITE OWNER COPY (FINAL) YELLOW OWNER COPY (INITIAL) PINK