IREDELL COUNTY HEALTH DEPARTMENT

STATESVILLE 704-878-5305 MOORESVILLE 704-664-5281

IMPROVEMENT PERMIT / AUTHORIZATION TO CONSTRUCT / OPERATION PERMIT / EXISTING SYSTEM INSPECTION

PERMIT# 79116 PIN# 4721086503 DATE 2-15-99

OWNER OR CONTRACTOR Anthony Day PHONE: Business 704 528 4830 Home

ADDRESS 1633 Eufola Rd Statesville

LOCATION Buffalo Shoals TL Eufola 1mi left 1599 Eufola Rd

SUBDIVISION BLOCK / SECTION LOT LOT AREA 1acre+ SITE CLASS DESIGN FLOW 360 L.T.A.R. .33

Septic Tank: 1000 Gallons: STB 160 Date 4-9-99
Pump Tank: Gallons: PT Date
Pump Make: Model Serial No.
Nitrification Field: No Fields 1 Square Feet 1080 Linear Feet 360
No Lines 6 Trench Width 36" Max Trench Bottom Depth 36" Gravel Depth 12"

☐ New System ☐ Repair System Type: I II III IV V VI
System Description: Conv. Gravity
Repair System Description: Pump to conv.
Maintenance Agreement Required: ☐ Yes ☑ No

☐ House/Mod. Home ☑ Mobile Home ☐ Business ☐ Other
No. Bedrooms 3 No. Bathrooms 2 No. Employees


☐ Slab ☐ Crawl Space ☐ Basement w/plumbing ☐ Basement wo/plumbing

Water Supply: ☑ Individual ☐ Public ☐ Community


Comments/Conditions:

Comments/Conditions: See Attached Sheet for As Built Sketch

INITIAL SITE SKETCH

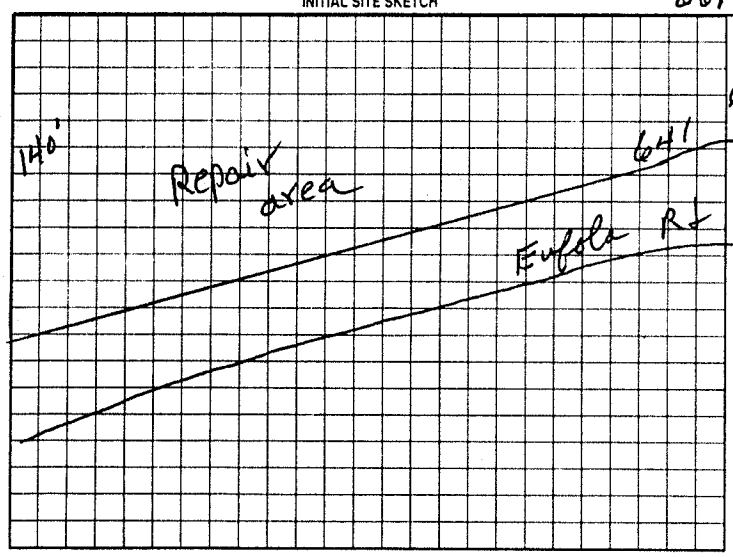

AS BUILT SKETCH

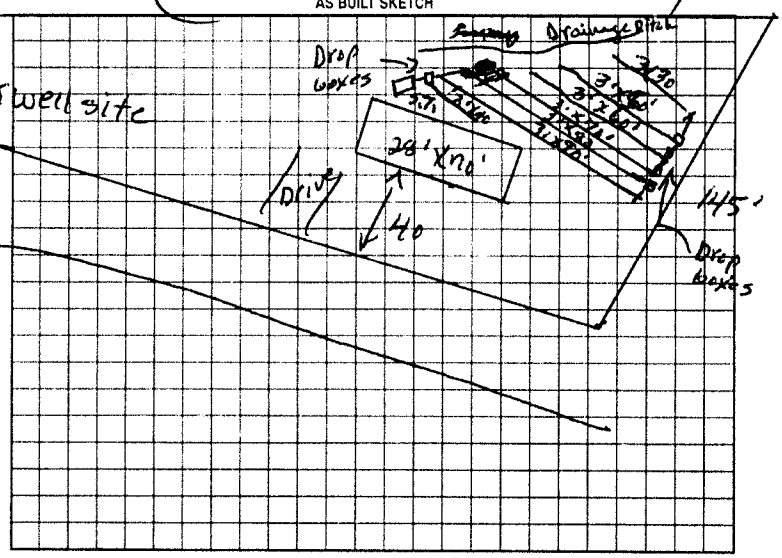

Permit can be suspended or revoked if any false information is supplied toward securing the permit/any unauthorized changes are made to the site/any unauthorized changes are made in the installation of the system. Improvement Permit with plat valid without expiration. Improvement Permit with site plan valid for sixty months. Authorization to Construct is valid for a period equal to that of Improvement Permit - not to exceed sixty months.

Signed: ~~P. Day~~ date Installed by: Barry Sigmon

Improvement Permit by: R. C. Moore date 2-15-99 Operation Permit by: R. C. Moore date 6-8-99

Authorization to Construct by: R. C. Moore date 2-15-99 Existing System Inspection by: date

HEALTH DEPT COPY WHITE OWNER COPY (FINAL) YELLOW OWNER COPY (INITIAL) PINK