48591

IREDELL COUNTY HEALTH DEPARTMENT

STATESVILLE 704-878-5305 MOORESVILLE 704-664-5281

IMPROVEMENT PERMIT / CERTIFICATE OF COMPLETION / OPERATION PERMIT / EXISTING SYSTEM INSPECTION

PROPERTY DESCRIPTION NO. 16921 DATE 8-30-93 TAX MAP NO. 3L-A-5E

OWNER OR CONTRACTOR Michael Davis PHONE: Business Home 528-4161

ADDRESS Rt 10, Box 165G Statesville, N.C. 28677

LOCATION I-40W TL Old Mtn. Rd. TR Buffalo Shoals Rd TL Pineville Rd. Th Ivy Oswalt Rd. 3rd home on R.

SUBDIVISION NA BLOCK / SECTION LOT — LOT AREA — SITE CLASS Existing LTAR →

Water Supply: ✓Individual ☐ Community ☐ Public Well

Septic Tank: Existing ~~Gallons; GTD~~ Date

Pump Tank: Gallons; PT Date

Nitrification Field: No Fields Square Feet Linear Feet

No Lines Trench Width Trench Depth Gravel Depth

☐ New System ☐ Repair System Type: I, II, III, IV, V, VI

System Description:

Repair System Description:

Maintenance Agreement Required: ☐ Yes ☐ No

✓House/Mod. Home No. Bedrooms 3

Mobile Home No. Bathrooms 2

Business No. Employees —

Other

Slab Crawl Space Basement w/plumbing ✓Basement wo/plumbing

Garbage Disposal: ☐ Yes ✓No

Auto. Dishwasher: ✓Yes ☐ No


Auto. Washing Machine: ✓Yes ☐ No

Other

Comments Building house (3 bedroom) in front of Existing 2 bedroom SWMH. When system was installed, it was done so for a three bedroom system dwelling. SWMH to be moved off when house completed. Keep [redacted]. Min. 5 from foundation of home.

INITIAL SITE SKETCH

AS BUILT SKETCH

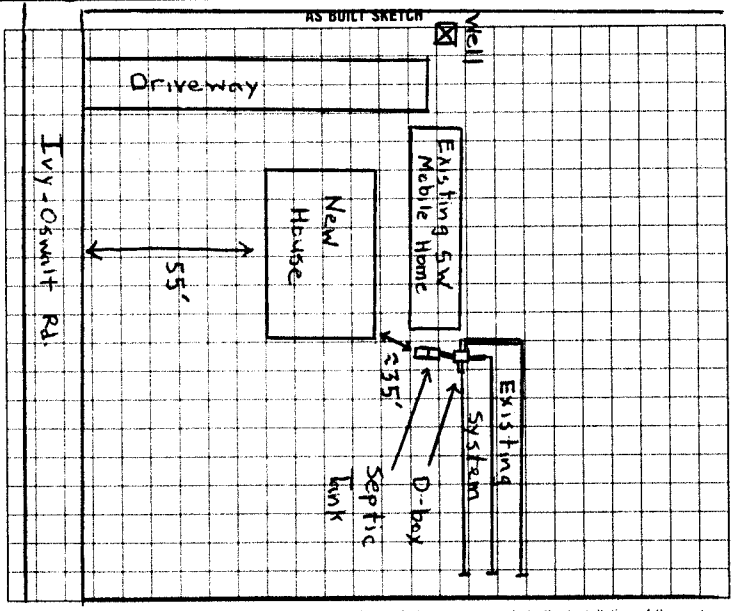

I understand that this permit can be suspended or revoked if any false information is supplied toward securing the permit/any unauthorized changes are made to the site/any unauthorized changes are made in the installation of the system. Improvement Permit is valid for 60 months from date of issuance.

Signed:

Improvement Permit by: date

Existing System Inspection by: Michael A. Dennis date 8-30-93

Installed by

Certificate of Completion by date

Operation Permit by date

HEALTH DEPT. COPY: WHITE INSPECTION COPY (FINAL) GREEN OWNER COPY (FINAL) YELLOW INSPECTION COPY (INITIAL) PINK OWNER COPY (INITIAL) GOLD