IREDELL COUNTY HEALTH DEPARTMENT

STATESVILLE 704-878-5305 MOORESVILLE 704-664-5281

IMPROVEMENT PERMIT / AUTHORIZATION TO CONSTRUCT / OPERATION PERMIT / EXISTING SYSTEM INSPECTION

PERMIT# REPAIR PIN# REPAIR 4721112681 DATE 4/29/05

OWNER OR CONTRACTOR GARY SETTLEMYRE PHONE: Business 525-0870 Home

ADDRESS 175 IVEY OSTWALT

LOCATION BUFFALO SHOALS - TL PINEVILLE RD - TL IVEY OSTWALT - 4TH DRIVE ON LEFT

SUBDIVISION BLOCK / SECTION LOT LOT AREA SITE CLASS. PS DESIGN FLOW 360 L.T.A.R.

Septic Tank: EXISTING Gallons; STB Date

Pump Tank: Gallons; PT Date

Pump Make: Model Serial No.

Nitrification Field: No Fields 1 Square Feet 975 Linear Feet 325

No Lines 4 Trench Width 36" Max Trench Bottom Depth 36" Gravel Depth 12"

☑ New System ☑ Repair System Type: I (II) III, IV, V, VI

System Description: ~~GRAVITY & LPP~~

Repair System Description: GRAVITY CONVENTIONAL

Maintenance Agreement Required: ☐ Yes ☑ No

☑ House/Mod. Home No. Bedrooms 3

☐ Mobile Home No. Bathrooms 3

☐ Business No. Employees

☐ Other


☐ Slab ☑ Crawl Space ☐ Basement w/plumbing ☐ Basement wo/plumbing

Water Supply: ☑ Individual ☐ Public ☐ Community


Comments:/Conditions: 1) SUPPLY LINE UNDER DRIVE TO BE SLEEVED WITH DUCTILE IRON OR EQUIVALENT
2) BULL RUN VALVE MAY BE INSTALLED

Comments:/Conditions: LINES HAD 7 ¼" FALL ACR 10'
IT IS ACCEPTABLE SO SHOT LINES
& WILL BACK UP TO BOX
APPEARED TO DRAIN & WE CONCLUDED
SYSTEM OK FOR REPAIR
WITH BEST PROFESSIONAL JUDGEMENT

1"=60' INITIAL SITE SKETCH

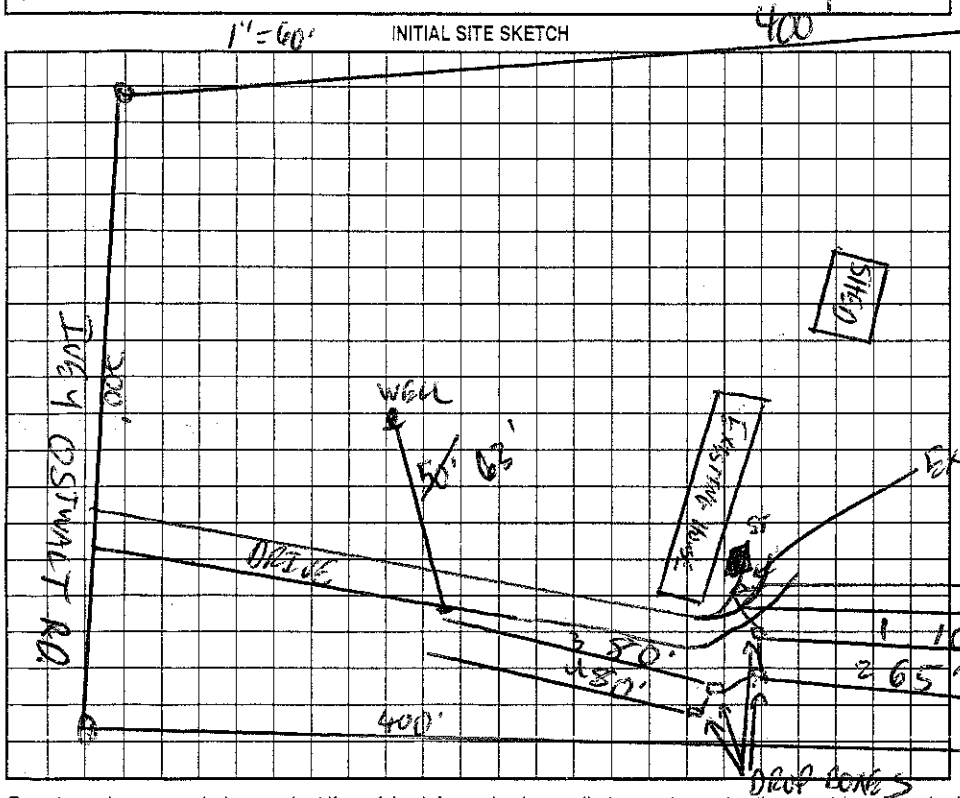

AS BUILT SKETCH

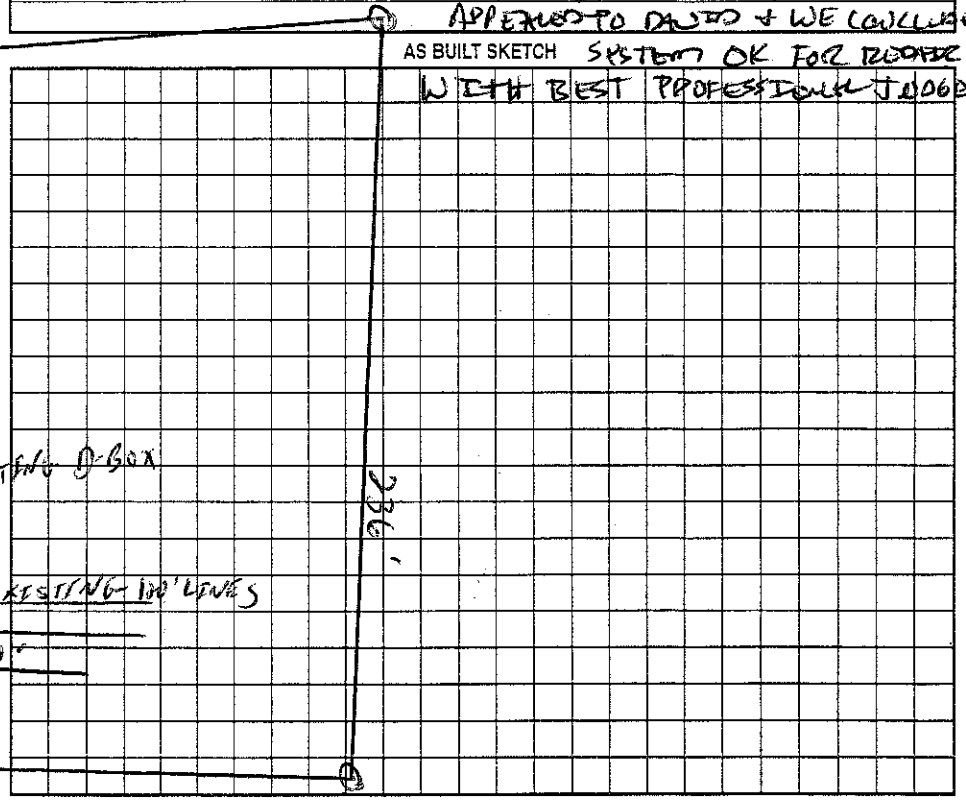

Permit can be suspended or revoked if any false information is supplied toward securing the permit/any unauthorized changes are made to the site/any unauthorized changes are made in the installation of the system. Improvement Permit with plat valid without expiration. Improvement Permit with site plan valid for sixty months. Authorization to Construct is valid for a period equal to that of Improvement Permit – not to exceed sixty months.

Signed: Gary W Settlemyre date 4-29-05 Installed by: SELF INSTALLED

Improvement Permit by: RS date 4/29/05 Operation Permit by: RS date 5-13-05

Authorization to Construct by: RS date 4/29/05 Existing System Inspection by: date

HEALTH DEPT. COPY: WHITE OWNER COPY (FINAL): YELLOW OWNER COPY (INITIAL): PINK