4th Hudler

IREDELL COUNTY HEALTH DEPARTMENT

STATESVILLE 704-878-5305 MOORESVILLE 704-664-5281

IMPROVEMENT PERMIT / AUTHORIZATION TO CONSTRUCT / OPERATION PERMIT / EXISTING SYSTEM INSPECTION

PERMIT# 076004 PIN# 4721 11 2286 (PART) DATE 8-29-98

OWNER OR CONTRACTOR RANDY SHARPE PHONE: Business Home 528-9959

ADDRESS 162 IVEY OSTWALT ROAD, STATESVILLE, NC 28677

LOCATION BUFFALO SHOALS ROAD, TL PINEVILLE RD, TL IVEY OSTWALT ROAD, LOT ON RIGHT AT #162

SUBDIVISION BLOCK / SECTION LOT LOT AREA 0.519 ACRE SITE CLASS. PS DESIGN FLOW 360 L.T.A.R. 0.30 GPD/FT²

Septic Tank: 1000 Gallons; STB 794 Date 5-29-98

Pump Tank: Gallons; PT Date

Pump Make: Model Serial No.

Nitrification Field: No Fields 1 Square Feet EQ TO 1200 Linear Feet 200

No Lines FOUR Trench Width 24" Max Trench Bottom Depth 36" Gravel Depth SAND 6"

☑ New System ☐ Repair System Type: I, II, III, IV, V, VI

System Description: PPBPS GRAVITY

Repair System Description: PPBPS - LATER

Maintenance Agreement Required: ☐ Yes ☑ No

☐ House/Mod. Home ☑ Mobile Home ☐ Business ☐ Other

No. Bedrooms 3 No. Bathrooms 2 No. Employees


☐ Slab ☑ Crawl Space ☐ Basement w/plumbing ☐ Basement wo/plumbing

Water Supply: ☑ Individual ☐ Public ☐ Community WELL


Comments:/Conditions: ① INSTALL FORTY-FOUR (44) PPBPS PANELS IN FOUR EQUAL LENGTH LINES ON CONTOUR AS SHOWN. ② USE THREE (3) FLOW DIVIDER TEES TO ACHIEVE EQUAL DISTRIBUTION ③ KEEP MAXIMUM FEASIBLE DISTANCE (75') FROM WELL

Comments:/Conditions:

INITIAL SITE SKETCH SCALE: 1"=30'

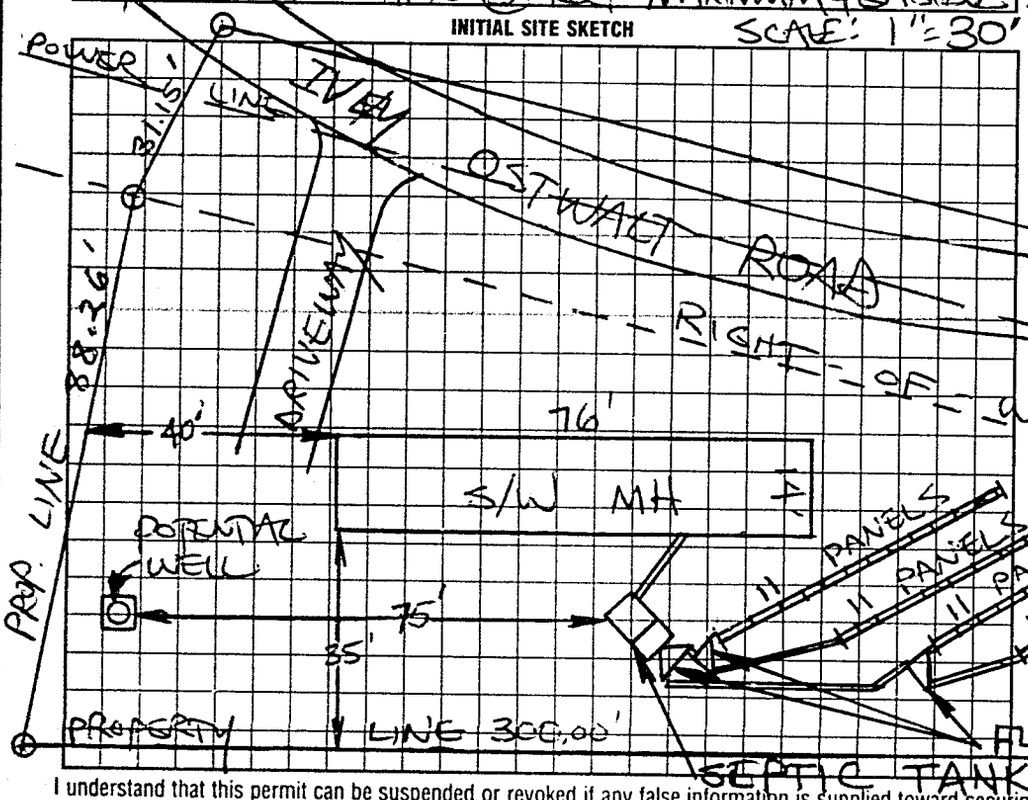

AS BUILT SKETCH

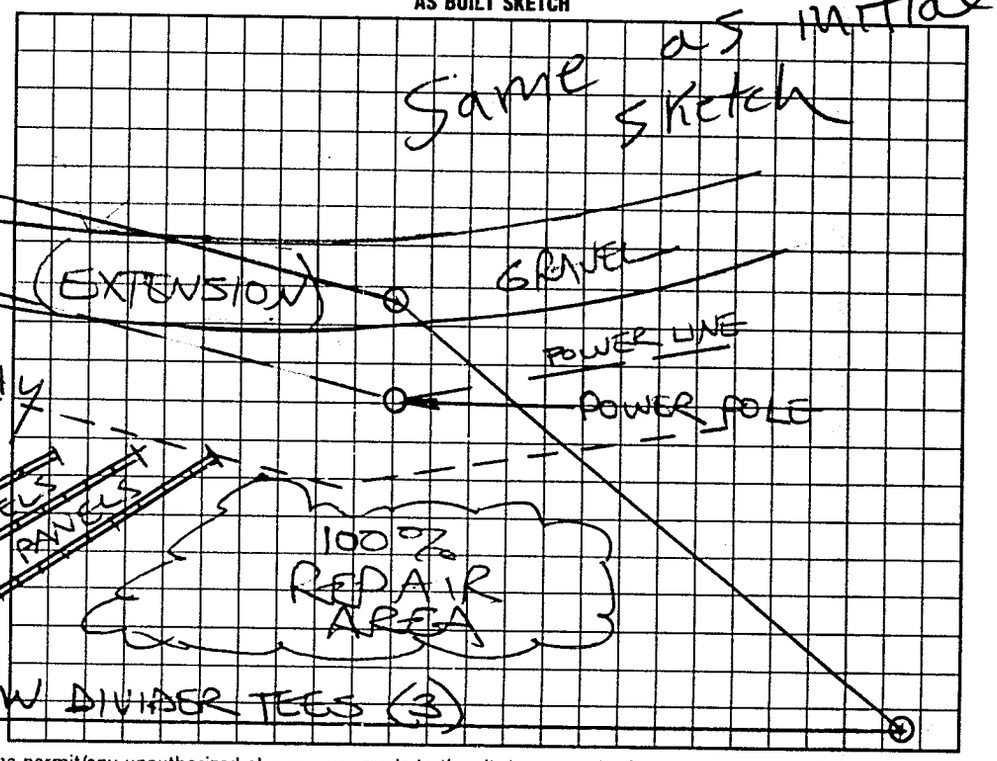

I understand that this permit can be suspended or revoked if any false information is supplied toward securing the permit/any unauthorized changes are made to the site/any unauthorized changes are made in the installation of the system. Improvement Permit with plat valid without expiration. Improvement Permit with site plan valid for sixty months. Authorization to Construct is valid for a period equal to that of Improvement Permit – not to exceed sixty months.

Signed: Connie Sharpe date 8-31-98 Installed by: James Hudler

Improvement Permit by: STEVE HEDRICK date 8-31-98 Operation Permit by: P.C. Moore date 9-15-98

Authorization to Construct by: STEVE HEDRICK date 8-31-98 Existing System Inspection by: date

HEALTH DEPT. COPY WHITE INSPECTION COPY (FINAL) GREEN OWNER COPY (FINAL) YELLOW INSPECTION COPY (INITIAL) PINK OWNER COPY (INITIAL) GOLD