IREDELL COUNTY HEALTH DEPARTMENT

Statesville Office (704) 878-5305 Mooresville Office (704) 660-3625

PERMIT # 222427

IMPROVEMENT PERMIT / AUTHORIZATION TO CONSTRUCT / OPERATION PERMIT / EXISTING SYSTEM

PIN # 4721-19-3369

APPLICANT: JANIE CASKADDON APPLICANT ADDRESS: 117 GREEN VALLEY RD. STATESVILLE

SITE ADDRESS: SAME PHONE: 704-528-5438 ALT. PHONE:

SITE DIRECTIONS: BUFFALO SHOALS, TL EUFOLA, TL GREEN VALLEY, ON R

SUBDIVISION: SECTION: LOT # LOT AREA: 5.3 AC DESIGN FLOW: L.T.A.R.:

Septic Tank 1000 (gal) STB 760 Date 9-7-16
Pump Tank (gal) PT Date
Pump Make Model Polylok Serial # PL-68
Nitrification Fields # Lines Linear Ft:
Trench Width Max. Trench Bottom Depth Gravel Depth

☐ New System ☑ Repair ☐ Expansion System Type: I (II) III IV V VI
System Description:
Repair System Description: TANK
Maintenance Agreement Required: ☐ YES ☑ NO
☑ GRAVITY ☐ PRESSURE


☑ Residence No. Bedrooms
☐ Business No. Persons
☐ Other No. Employees
☐ Slab ☐ Crawl Space
☑ Basement w/plumbing ☐ Basement w/o plumbing

Water Supply
☑ Private
☐ Public
☐ Community

Comments / Conditions: PUMP, CRUSH, FILL OLD TANK
REPLACE D-BOX IF NEEDED

R 450'

INITIAL SITE SKETCH

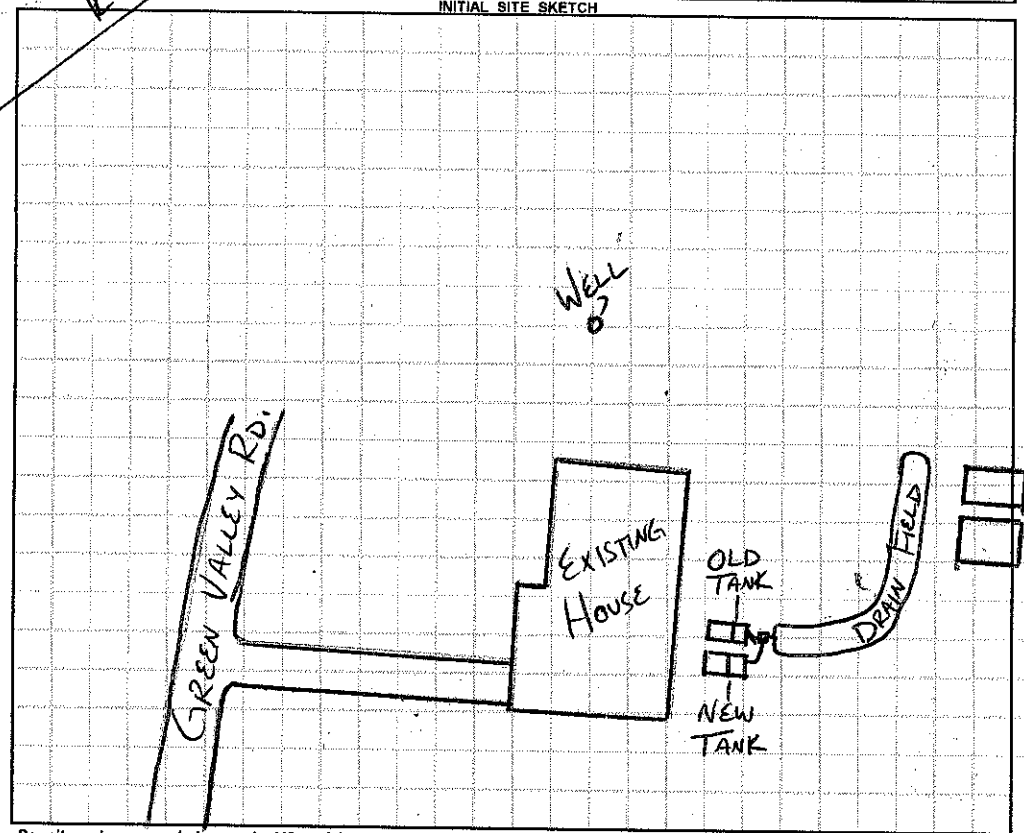

AS BUILT SKETCH

Installed as drawn

Permit can be suspended or revoked if any false information is supplied toward securing the permit / any unauthorized changes are made to the site / any unauthorized changes are made in the installation of the system. **CONTACT A LOCATOR SERVICE PRIOR TO ANY EXCAVATION**

☐ **IMPROVEMENT PERMIT** *with plat valid without expiration.* ☑ **IMPROVEMENT PERMIT** *with site plan valid for 60 mos.* ☑ **AUTHORIZATION TO CONSTRUCT** *valid for period equal to IMPROVEMENT PERMIT--not to exceed 60 mo.*

Owner / Applicant Signature: Janie Louise Caskaddon Date: 12-8-16 Installed by: Lentz Wastewater

IMPROVEMENT PERMIT by: RA Date: 11-16-16 OPERATION PERMIT by: Date: 12/16/16

AUTHORIZATION TO CONSTRUCT by: RA Date: 11-16-16 Existing System Inspected by: Date:

Health Dept. Copy - WHITE Applicant (Final Approval) - YELLOW Applicant (Conditional Approval) - PINK