IREDELL COUNTY HEALTH DEPARTMENT

STATESVILLE 704-878-5305 MOORESVILLE 704-664-5281

IMPROVEMENT PERMIT / AUTHORIZATION TO CONSTRUCT / OPERATION PERMIT / EXISTING SYSTEM INSPECTION

PERMIT # Repair PIN # 4721303672 DATE 6-8-09

OWNER or APPLICANT JOANN OVERCASH PHONE: Business 704-528-5902 Home: 704-871-6483

OWNER or APPLICANT ADDRESS 157 LOFTIN LANE Troutman NC 28166

LOCATION / DIRECTIONS 21 SOUTH ® DAM ® EAST MONBO ® LOFTIN LANE ATTENDS ON LEFT

SUBDIVISION BLOCK / SECTION LOT # LOT AREA 11.17 DESIGN FLOW 240 L.T.A.R.

Septic Tank EXISTING Gallons: STB Date

Pump Tank Gallons: PT Date

Pump Make Model Serial #

Nitrification Field No Fields No Lines Linear Feet

Trench Width Max. Trench Bottom Depth Gravel Depth

☒ New System ☒ Repair ☐ Expansion System Type I II (III) IV V VI

System Description: GRAVITY 25% REDUCT

Repair System Description:

Maintenance Agreement Required ☐ YES ☒ NO

☒ GRAVITY ☐ PRESSURE

☒ Residence No. Bedrooms 2

☐ Business No. Persons

☐ Other No. Employees

☐ Slab ☐ Crawl Space


☒ Basement w/plumbing ☐ Basement w/o plumbing

Water Supply: ☒ Private ☐ Public ☐ Community


Comments / Conditions ① Install 4 Lines 60' LONG using 25% REDUCTION 4 Repair ② ✓ TANK & TEE in tank ③ BK installation consultative visit must be made

Comments / Conditions

INITIAL SITE SKETCH

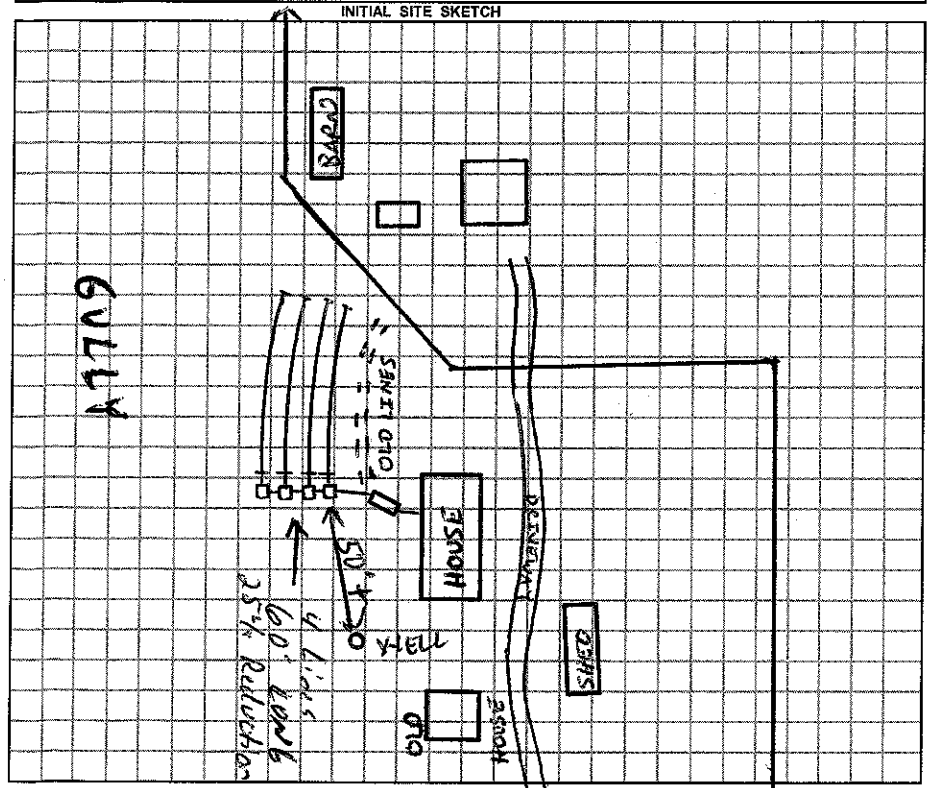

AS BUILT SKETCH

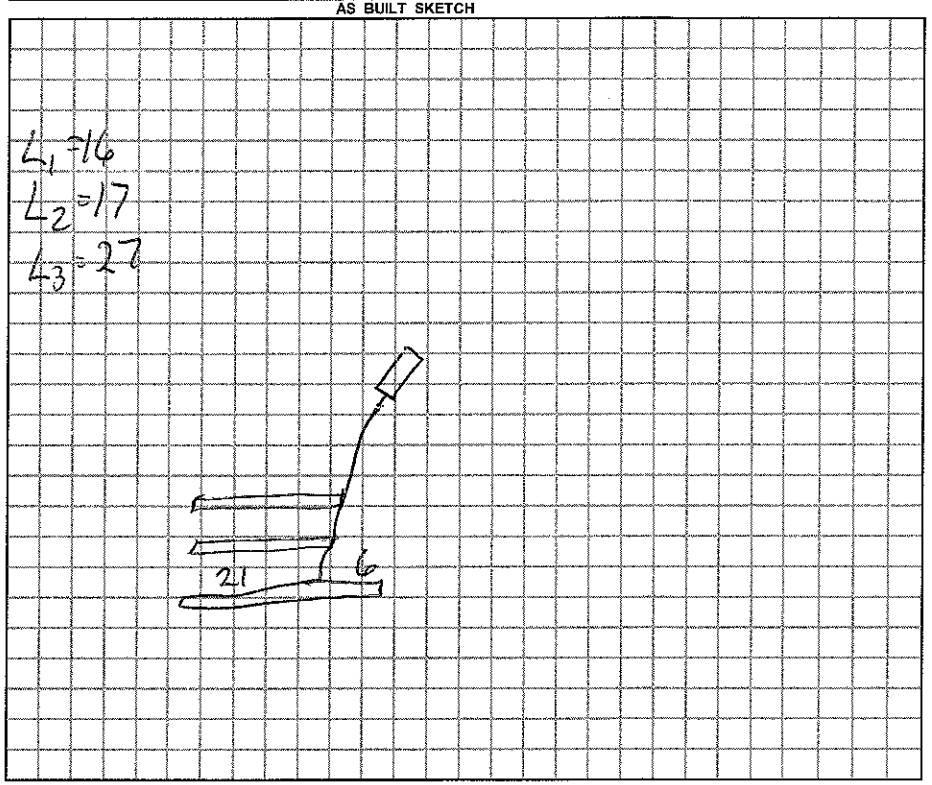

Permit can be suspended or revoked if any false information is supplied toward securing the permit / any unauthorized changes are made to the site / any unauthorized changes are made in the installation of the system.

☐ *IMPROVEMENT PERMIT w / plat valid without expiration.* ☐ *IMPROVEMENT PERMIT w / site plan valid for 60 mos.* ☐ *AUTHORIZATION TO CONSTRUCT valid for period equal to IMPROVEMENT PERMIT-not to exceed 60 mo.*

Owner / Applicant Signature: Joann L Overcash Date

Improvement Permit by: Date 6-8-09

Authorization to Construct by: Date 6-8-09

Installed by: A-1 Backhoe

Operation Permit by: Date: 6-9-09

Existing System Inspected by: Date:

YOU SHOULD CONTACT A LOCATOR SERVICE PRIOR TO ANY EXCAVATION.

WHITE COPY Environmental Health YELLOW COPY (Final) Owner / Applicant PINK COPY (Initial) Owner / Applicant