3:30

IREDELL COUNTY HEALTH DEPARTMENT

STATESVILLE 704-878-5305 MOORESVILLE 704-664-5281

IMPROVEMENT PERMIT / AUTHORIZATION TO CONSTRUCT / OPERATION PERMIT / EXISTING SYSTEM INSPECTION

PERMIT # 158307 PIN # 4721-36-8901.559 37-4193 DATE 9-30-09

OWNER or APPLICANT Terry Watts PHONE: Business 704 987 0955 Home: 704 528 6886

OWNER or APPLICANT ADDRESS 539 Troutman Farm Rd

LOCATION / DIRECTIONS 215, (R) on Old Mtn. Rd, (L) Troutman Farm Rd.

SUBDIVISION n/a BLOCK / SECTION LOT # n/a LOT AREA 1.731 DESIGN FLOW 360 L.T.A.R. .3

Septic Tank 1000 Gallons: STB 1017 Date 7-14-08

Pump Tank 1000 Gallons: PT 1017 Date 3-3-09

Pump Make Gould Model WE07L2HV Serial #

Nitrification Field No Fields 1 No Lines 3 Linear Feet 320' each total

Trench Width 36" Max. Trench Bottom Depth 36" Gravel Depth n/a

☐ New System ☐ Repair ☐ Expansion System Type I II (III) IV V VI

System Description: 25% Reduction Pump

Repair System Description: 25% Reduction Pump

Maintenance Agreement Required ☐ YES ☒ NO

☐ GRAVITY ☒ PRESSURE


☒ Residence No. Bedrooms 3 ☐ Business No. Persons ☐ Other No. Employees ☐ Slab ☐ Crawl Space ☒ Basement w/plumbing ☐ Basement w/o plumbing

Water Supply: ☒ Private ☐ Public ☐ Community


Comments / Conditions

Comments / Conditions

INITIAL SITE SKETCH

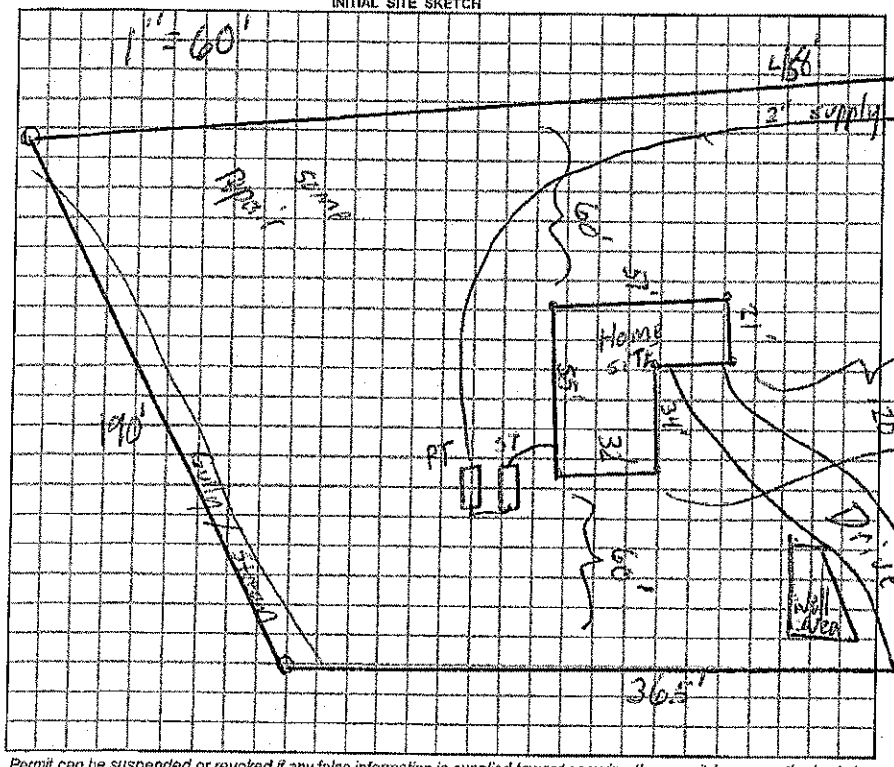

AS BUILT SKETCH

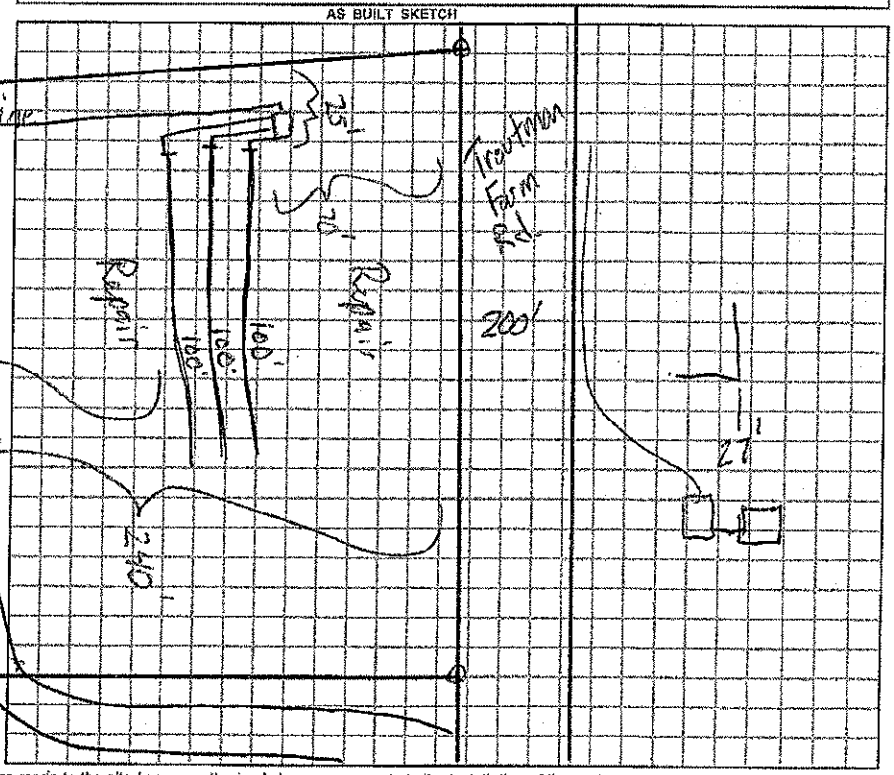

Permit can be suspended or revoked if any false information is supplied toward securing the permit / any unauthorized changes are made to the site / any unauthorized changes are made in the installation of the system.

☐ IMPROVEMENT PERMIT w / plat valid without expiration. ☒ IMPROVEMENT PERMIT w / site plan valid for 60 mos. ☒ AUTHORIZATION TO CONSTRUCT valid for period equal to IMPROVEMENT PERMIT-not to exceed 60 mo.

Owner / Applicant Signature: Date 10-2-09

Improvement Permit by: Date 9-30-09

Authorization to Construct by: Date 9-30-09

YOU SHOULD CONTACT A LOCATOR SERVICE PRIOR TO ANY EXCAVATION.

Installed by: Young Sanding

Operation Permit by: Date: 5-3-10

Existing System Inspected by: Date:

WHITE COPY Environmental Health YELLOW COPY (Final) Owner / Applicant PINK COPY (Initial) Owner / Applicant