IREDELL COUNTY HEALTH DEPARTMENT

STATESVILLE 704-878-5305 MOORESVILLE 704-664-5281

(EX) IMPROVEMENT PERMIT / AUTHORIZATION TO CONSTRUCT / OPERATION PERMIT / EXISTING SYSTEM INSPECTION

PERMIT# 105294 PIN# 4721-46-5653 DATE 3-25-02

OWNER OR CONTRACTOR ALTON KIRKMAN PHONE: Business _____ Home 704-875-6345

ADDRESS 11815 ASBURY CHAPEL RD, HUNTERSVILLE NC 28078

LOCATION US 21 S, TR OLD MTN. ROAD, TL TROUTMAN FARM RD, 1.6 MILES TL IN CURVE BIGHAM LN Near or on 2R

SUBDIVISION _____ BLOCK / SECTION _____ LOT _____ LOT AREA 6.1172 ACRES SITE CLASS PS DESIGN FLOW 360 L.T.A.R. 0.40 GPD/FT

Septic Tank: ~~1000~~ 1500 Gallons: STB 338 Date 07/05/02

Pump Tank: _____ Gallons, PT _____ Date _____

Pump Make: _____ Model _____ Serial No _____

Nitrification Field: No Fields 1 Square Feet 900 Linear Feet 300

No Lines THREE Trench Width 36" Max Trench Bottom Depth 36" Gravel Depth 12"

☑ New System ☐ Repair System Type: I II III IV V VI

System Description: CONVENTIONAL GRAVITY

Repair System Description: CONVENTIONAL GRAVITY

Maintenance Agreement Required: ☐ Yes ☑ No

☑ House/Mod. Home No. Bedrooms 3

☐ Mobile Home No. Bathrooms 2

☐ Business No. Employees ____

☐ Other _____


☐ Slab ☑ Crawl Space ☐ Basement w/plumbing ☐ Basement wo/plumbing

Water Supply: ☑ Individual ☐ Public ☐ Community WELL

Comments/Conditions: KEEP SYSTEM MINIMUM 100 FEET FROM WELL

Comments/Conditions: ① SEPTIC TANK INSTALLED USING ABEL FILTER + SEPTIC TANK MARKER

INITIAL SITE SKETCH

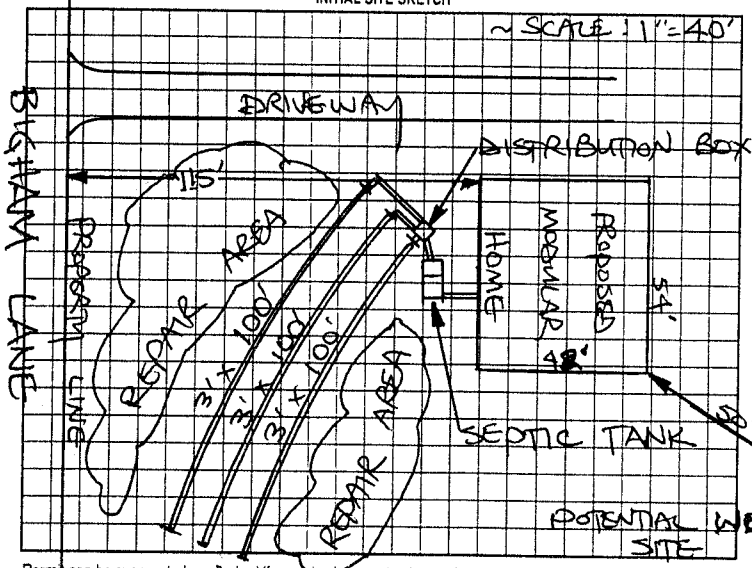

AS BUILT SKETCH

SYSTEM INSTALLED AS SHOWN IN INITIAL SITE SKETCH

Permit can be suspended or revoked if any false information is supplied toward securing the permit/any unauthorized changes are made to the site/any unauthorized changes are made in the installation of the system. Improvement Permit with plat valid without expiration. Improvement Permit with site plan valid for sixty months. Authorization to Construct is valid for a period equal to that of Improvement Permit – not to exceed sixty months.

Signed: Hatton Tomberlin date 3-25-02 Installed by: Sharp's Custom Grading Charlie Sharp

Improvement Permit by: STEVE HEDRICK date 3-25-02 Operation Permit by: Patsy Mitchell date 08/07/02

Authorization to Construct by: STEVE HEDRICK date 3-25-02 Existing System Inspection by: _____ date _____

HEALTH DEPT. COPY WHITE OWNER COPY (FINAL) YELLOW OWNER COPY (INITIAL) PINK