IREDELL COUNTY HEALTH DEPARTMENT

STATESVILLE 704-878-5305 MOORESVILLE 704-664-5281

IMPROVEMENT PERMIT / AUTHORIZATION TO CONSTRUCT / OPERATION PERMIT / EXISTING SYSTEM INSPECTION

PERMIT# 142577 PIN# 4721-48-6573 DATE 5-24-07

OWNER OR APPLICANT MICHAEL KING PHONE: Business 704-450-3936 Home

ADDRESS 113 TANGLE LANE STATESVILLE NC 28677

LOCATION OLD MOUNTAIN ROAD TO TROUTMAN FARM ROAD TR TANGLE LANE, 2ND LOT ON LEFT

SUBDIVISION BLOCK / SECTION LOT 2 LOT AREA 1.395 Acres SITE CLASS. PS DESIGN FLOW 480 L.T.A.R. 0.35 GPD/FT²

Septic Tank: EXISTING Gallons: STB Date

Pump Tank: Gallons: PT Date

Pump Make: Model EZ-Flo Serial No.

Nitrification Field: No Fields 1 Square Feet 688 Linear Feet 172

No Lines TWO Trench Width 36" Max Trench Bottom Depth 36" +/- Gravel Depth N/A

☐ New System ☐ Repair ☑ Expansion System Type: I II IV V VI

System Description: 25% REDUCTION GRAVITY

Repair System Description: 25% REDUCTION, GRAVITY

Maintenance Agreement Required: ☐ Yes ☑ No

☐ House/Mod. Home No. Bedrooms 4

☐ Mobile Home No. Persons

☐ Business No. Employees

☐ Other


Water Supply: ☑ Individual ☐ Public ☐ Community WELL

☑ Gravity ☐ Pressure ☐ Slab ☑ Crawl Space ☐ Basement w/plumbing ☐ Basement wo/plumbing


Comments:/Conditions: TIE INTO EXISTING LINE AS SHALLOW AS POSSIBLE FEEDING TWO NEW 25% REDUCTION LINES ON CONTOUR AS FLAGGED (TIE INTO END-CAPS IF NECESSARY.

Comments:/Conditions:

INITIAL SITE SKETCH

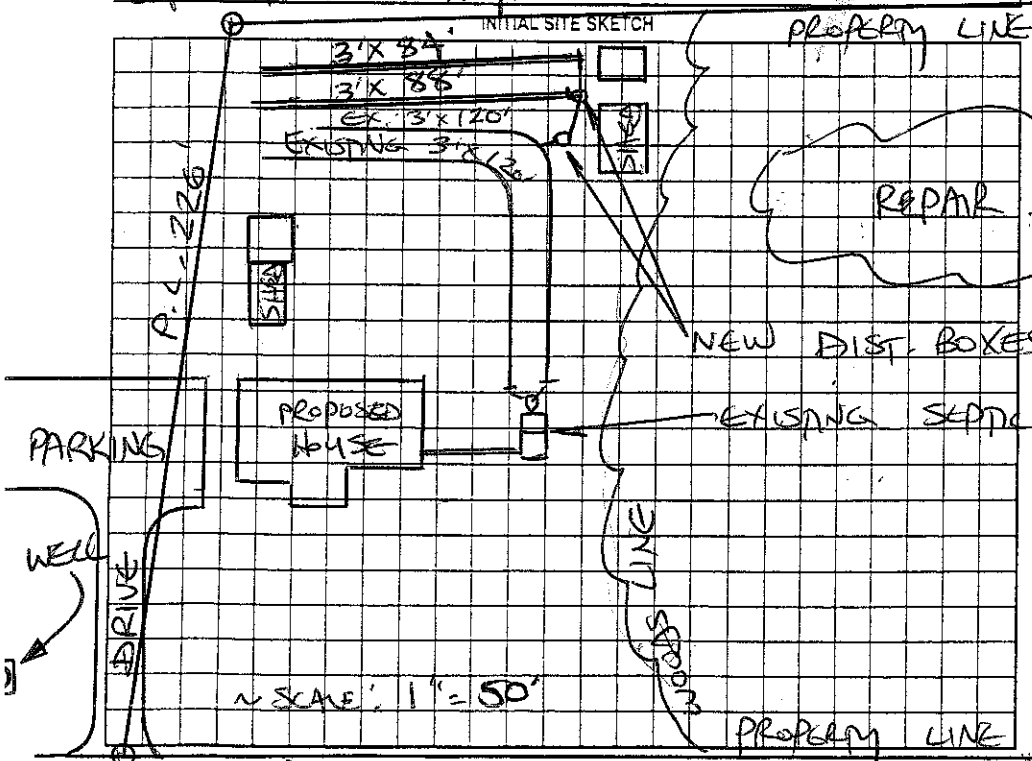

AS BUILT SKETCH

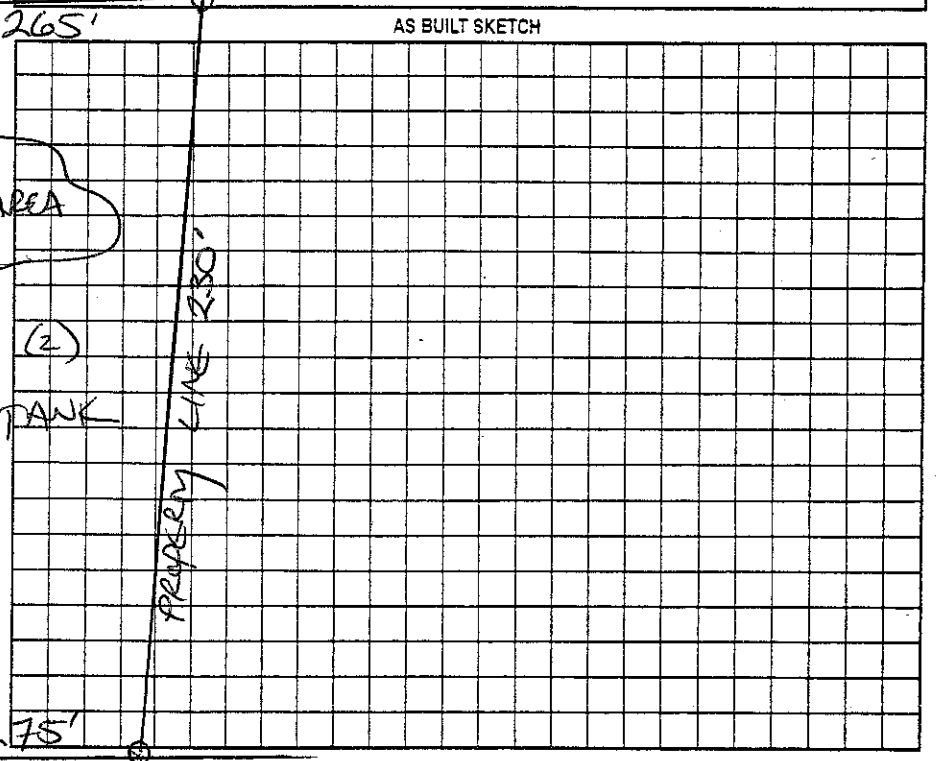

Permit can be suspended or revoked if any false information is supplied toward securing the permit/any unauthorized changes are made to the site/any unauthorized changes are made in the installation of the system. Improvement Permit with plat valid without expiration ☐ Improvement Permit with site plan valid for sixty months ☑ Authorization to Construct is valid for a period equal to that of Improvement Permit – not to exceed sixty months.

Signed: date 5/24/07 Installed by: Steve Jordan

Improvement Permit by: STEVE HEDRICK date 5-24-07 Operation Permit by: date 7-19-07

Authorization to Construct by: STEVE HEDRICK date 5-24-07 Existing System Inspection by: date

HEALTH DEPT. COPY: WHITE OWNER COPY (FINAL): YELLOW OWNER COPY (INITIAL): PINK