IREDELL COUNTY HEALTH DEPARTMENT

STATESVILLE 704-878-5305 MOORESVILLE 704-664-5281

IMPROVEMENT PERMIT / AUTHORIZATION TO CONSTRUCT / OPERATION PERMIT / EXISTING SYSTEM INSPECTION

PERMIT# 075851 PIN# 4721506358

OWNER OR CONTRACTOR Sandra Davis PHONE: Business 872-2444 Home DATE 8-7-98

ADDRESS 797 E Monbo Rd Statesville NC

LOCATION E Monbo 9th Place or (L) Past Talley Rd

SUBDIVISION BLOCK / SECTION LOT LOT AREA SITE CLASS. P/S DESIGN FLOW 360 L.T.A.R. 0.32

Septic Tank: 1000 Ex. Gallons; STB Date
Pump Tank: Gallons; PT Date
Pump Make: Model Serial No.
Nitrification Field: No Fields 1 Square Feet Linear Feet 120
No Lines 2 Trench Width 36in Max Trench Bottom Depth 36in Gravel Depth 12in

[X] New System [ ] Repair System Type: I, (II), III, IV, V, VI
System Description: Gravity Conventional
Repair System Description:
Maintenance Agreement Required: [ ] Yes [X] No


[ ] House/Mod. Home No. Bedrooms 3
[X] Mobile Home No. Bathrooms 2
[ ] Business No. Employees
[ ] Other
[ ] Slab [X] Crawl Space [ ] Basement w/plumbing [ ] Basement wo/plumbing

Water Supply: [X] Individual [ ] Public [ ] Community


Comments:/Conditions: Install 2 lines on Contour 9 ft on Center. Start of lines will be slightly deeper

Comments:/Conditions: Double wide set in place of Singlewide

INITIAL SITE SKETCH

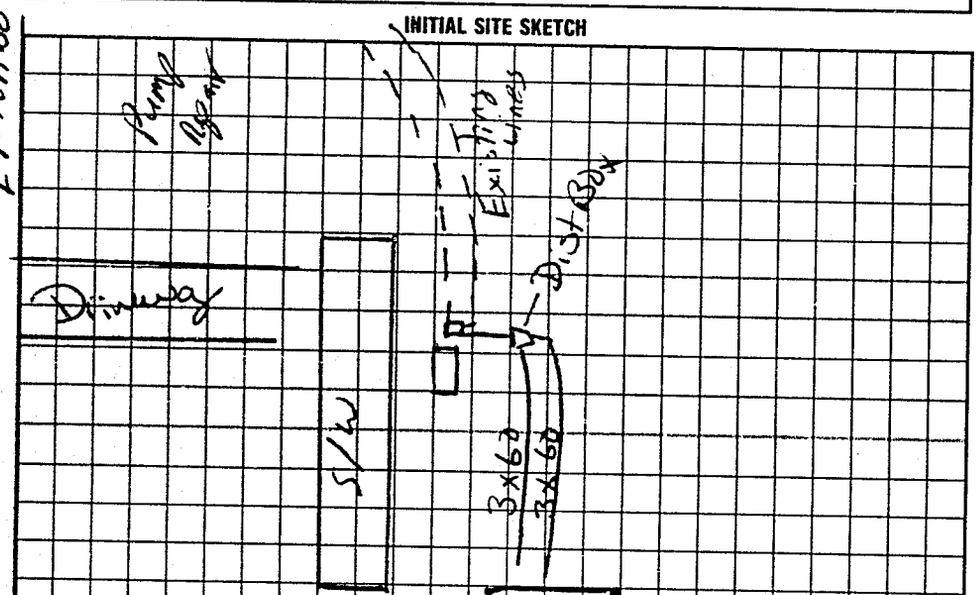

AS BUILT SKETCH

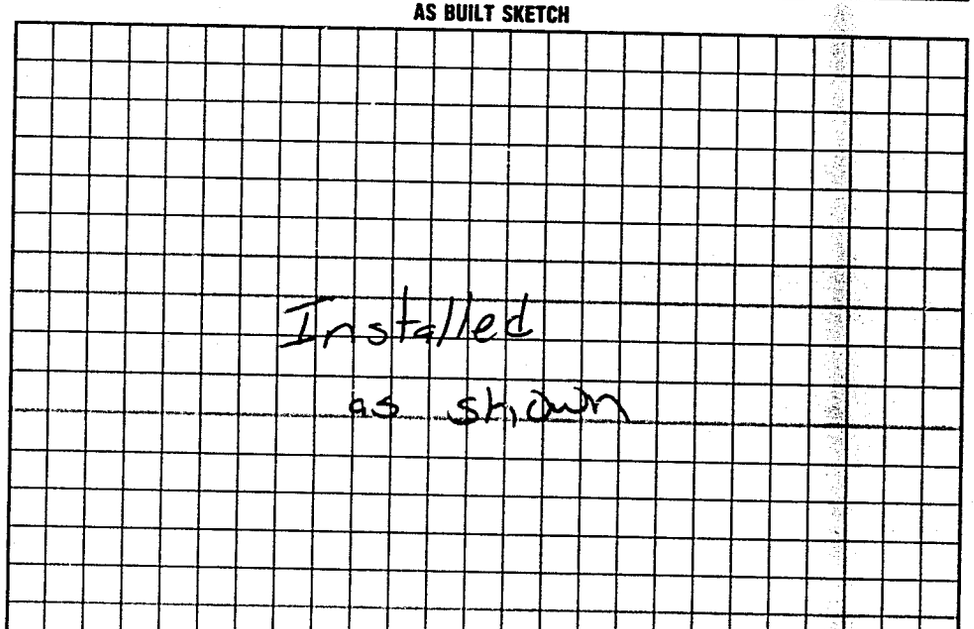

I understand that this permit can be suspended or revoked if any false information is supplied toward securing the permit/any unauthorized changes are made to the site/any unauthorized changes are made in the installation of the system. Improvement Permit with plat valid without expiration. Improvement Permit with site plan valid for sixty months. Authorization to Construct is valid for a period equal to that of Improvement Permit – not to exceed sixty months.

Signed: Sandra Davis date

Improvement Permit by: Mark Curtis date 8-7-98

Authorization to Construct by: Mark Curtis date 8-7-98

Installed by: Wards Grading

Operation Permit by: Mark Curtis date 9-24-98

Existing System Inspection by: date

HEALTH DEPT COPY WHITE INSPECTION COPY (FINAL) GREEN OWNER COPY (FINAL) YELLOW INSPECTION COPY (INITIAL) PINK OWNER COPY (INITIAL) GOLD