IREDELL COUNTY HEALTH DEPARTMENT

Statesville Office (704) 878-5305 Mooresville Office (704) 660-3625 PERMIT # 215957

IMPROVEMENT PERMIT / AUTHORIZATION TO CONSTRUCT / OPERATION PERMIT / EXISTING SYSTEM

PIN # 4721-53-7944

APPLICANT: Jake Sherrill APPLICANT ADDRESS: 772 Washington Ave. Statesville, NC 28677

SITE ADDRESS: 600 E. Monbo Road. Statesville, NC PHONE: 704-437-4627 ALT. PHONE:

SITE DIRECTIONS: E. Monbo Rd West from Troutman → Entrance to Parcel is across road from Hicks Creek Intersection

SUBDIVISION: — SECTION: — LOT # — LOT AREA: 19.890 acres DESIGN FLOW: 240 GPD L.T.A.R.: 0.30

Septic Tank	1000	(gal)	STB	760	Date	9-5-16	☒ New System	☐ Repair	☐ Expansion	System Type: I II (III) IV V VI	
Pump Tank	—	(gal)	PT	—	Date	—	System Description:	25% Reduction			
Pump Make	—	Model	—	Serial #	—		Repair System Description:	Drip			
# Nitrification Fields	1	# Lines	4	Linear Ft:	200		Maintenance Agreement Required:	☐ YES	☒ NO		
Trench Width	36"	Max. Trench Bottom Depth	26" [Low side]	Gravel Depth	—		☒ GRAVITY	☐ PRESSURE			


☒ Residence No. Bedrooms 2 — ☐ Business No. Persons 4 — ☐ Other No. Employees — — ☐ Slab ☐ Crawl Space — ☒ Basement w/plumbing ☐ Basement w/o plumbing

Water Supply: ☒ Private ☐ Public ☐ Community

Comments / Conditions: Follow all N.C. septic rules. Recommend pumping septic tank every 3-5 years. Though ≈240 l.f. of drainfield was laid out only 200 l.f. of 25% reduction need be installed.

Supply line ~ 12 Ft

INITIAL SITE SKETCH

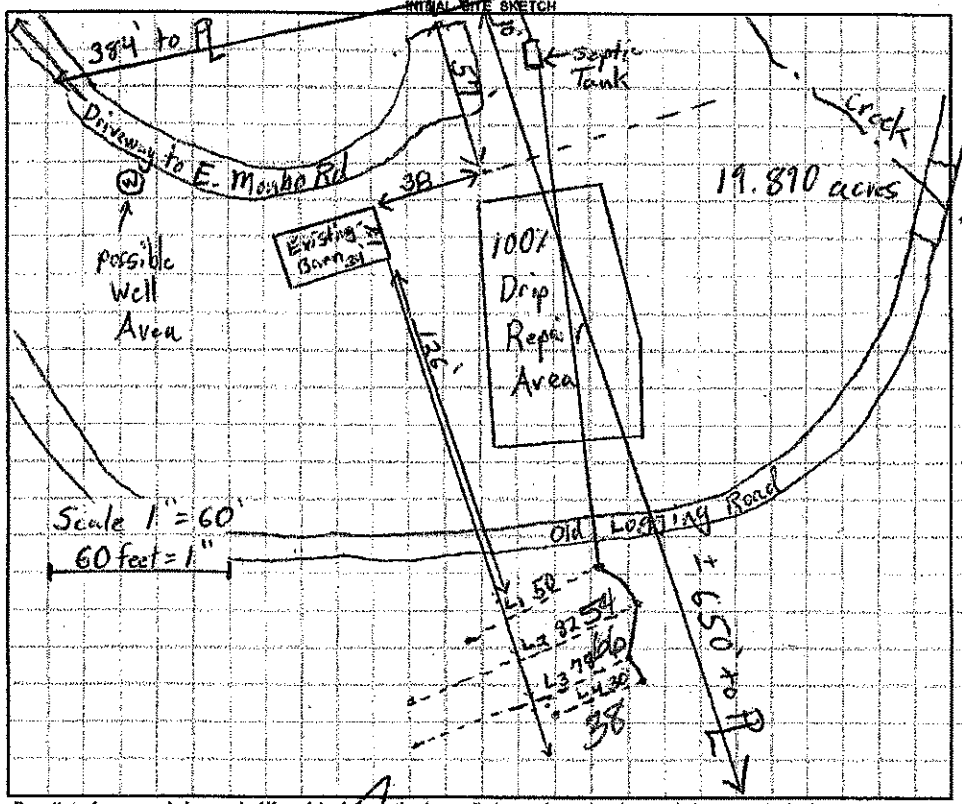

AS BUILT SKETCH

Used Quick 4 for Drainfield

Permit can be suspended or revoked if any false information is supplied toward securing the permit / any unauthorized changes are made to the site / any unauthorized changes are made in the installation of the system. **CONTACT A LOCATOR SERVICE PRIOR TO ANY EXCAVATION**

☐ **IMPROVEMENT PERMIT** *with plat valid without expiration.* ☒ **IMPROVEMENT PERMIT** *with site plan valid for 60 mos.* ☒ **AUTHORIZATION TO CONSTRUCT** *valid for period equal to IMPROVEMENT PERMIT--not to exceed 60 mo.*

Owner / Applicant Signature: [signature] 11-22-16 Date: Installed by: A-1 Backhoe

IMPROVEMENT PERMIT by: [signature] Date: 11-10-16 OPERATION PERMIT by: Marian Dotson Date: 12/13/16

AUTHORIZATION TO CONSTRUCT by: [signature] Date: 11-10-16 Existing System Inspected by: Date:

Health Dept. Copy - WHITE Applicant (Final Approval) - YELLOW Applicant (Conditional Approval) - PINK