IREDELL COUNTY HEALTH DEPARTMENT

Statesville Office (704) 878-5305 Mooresville Office (704) 660-3625 PERMIT # 208478

IMPROVEMENT PERMIT / AUTHORIZATION TO CONSTRUCT / OPERATION PERMIT / EXISTING SYSTEM

PIN # 4721613306

APPLICANT: Lloyd Odell APPLICANT ADDRESS: 750 E. Monbo Rd Statesville NC 28677

SITE ADDRESS: 750 E Monbo Rd Statesville NC 28677 PHONE: 1-704-728-8878 ALT. PHONE: N/A

SITE DIRECTIONS: Hwy 115 T/R on Talley T/L on Monbo Property on Right

SUBDIVISION: N/A SECTION: N/A LOT # N/A LOT AREA: 1.18ac DESIGN FLOW: 360 L.T.A.R.: Ex

Septic Tank	Ex	(gal)	STB		Date						
Pump Tank		(gal)	PT		Date						
Pump Make			Model		Serial #						
# Nitrification Fields	Ex		# Lines	Ex	Linear Ft:	Ex					
Trench Width	Ex		Max. Trench Bottom Depth	Ex	Gravel Depth	Ex					

☐ New System ☐ Repair ☐ Expansion System Type: I ☑ II III IV V VI

System Description: Existing

Repair System Description:

Maintenance Agreement Required: ☐ YES ☒ NO

☒ GRAVITY ☐ PRESSURE

☒ Residence ☐ Business ☐ Other ☐ Slab ☐ Basement w/plumbing


No. Bedrooms 3 No. Persons 6 No. Employees ☐ Crawl Space

Water Supply: ☒ Private ☐ Public ☐ Community ☒ Basement w/o plumbing

Comments / Conditions: All building foundations must be 55' from any part of STS. and 25' from any well.

INITIAL SITE SKETCH

AS BUILT SKETCH (2091) P/L

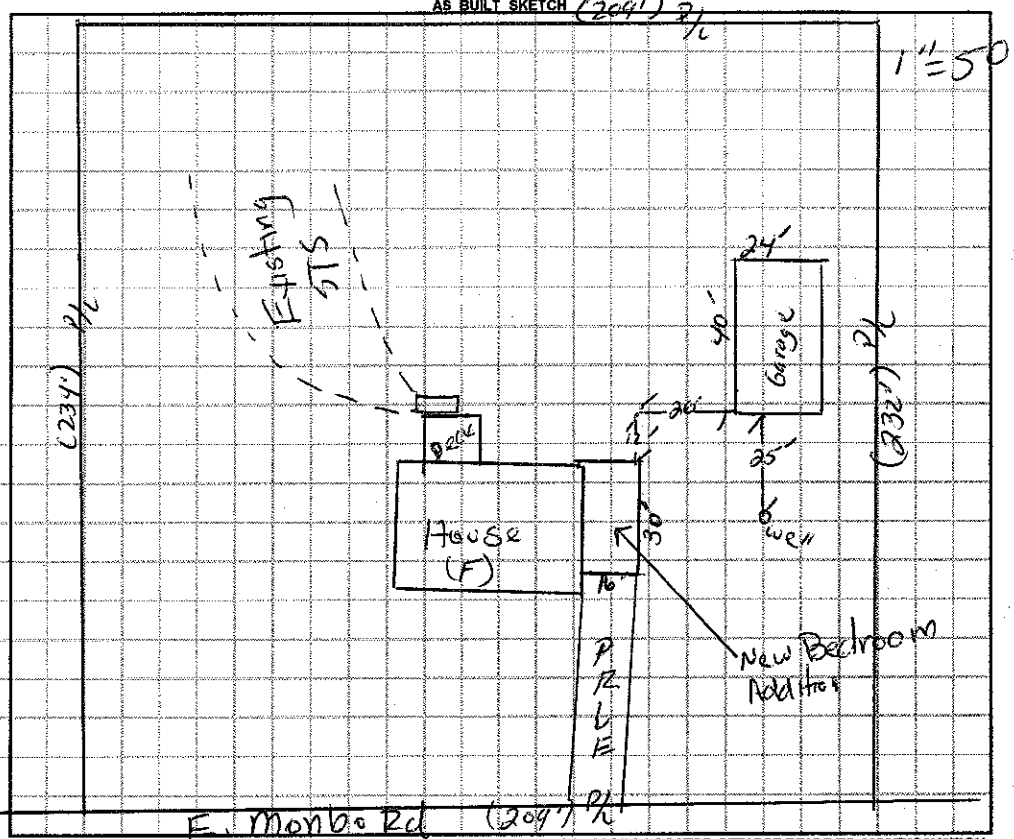

Permit can be suspended or revoked if any false information is supplied toward securing the permit / any unauthorized changes are made to the site / any unauthorized changes are made in the installation of the system. **CONTACT A LOCATOR SERVICE PRIOR TO ANY EXCAVATION**

☐ **IMPROVEMENT PERMIT** *with plat valid without expiration.* ☐ **IMPROVEMENT PERMIT** *with site plan valid for 60 mos.* ☐ **AUTHORIZATION TO CONSTRUCT** *valid for period equal to IMPROVEMENT PERMIT--not to exceed 60 mo.*

Owner / Applicant Signature: Lloyd Odell Date: Installed by:

IMPROVEMENT PERMIT by: Date: OPERATION PERMIT by: Date:

AUTHORIZATION TO CONSTRUCT by: Date: Existing System Inspected by: Debbie H. Lowe Date: 03/16/15

Health Dept. Copy - WHITE Applicant (Final Approval) - YELLOW Applicant (Conditional Approval) - PINK