IREDELL COUNTY HEALTH DEPARTMENT

STATESVILLE 704-878-5305 MOORESVILLE 704-664-5281

IMPROVEMENT PERMIT / AUTHORIZATION TO CONSTRUCT / OPERATION PERMIT / EXISTING SYSTEM INSPECTION

PERMIT# REPAIR PIN# DATE 1-14-98

OWNER OR CONTRACTOR BOBBY SHERRILL PHONE: Business Home 528-5253

ADDRESS 726 E. MONBO ROAD STATESVILLE, NC

LOCATION I-40 W, TL OLD MTN ROAD, TR E. MONBO ROAD, 5TH HOUSE ON RIGHT PAST HICKS CREEK ROAD

SUBDIVISION BLOCK / SECTION LOT LOT AREA AMPLE SITE CLASS. PS DESIGN FLOW 360 L.T.A.R. EXISTING

Septic Tank: EXISTING Gallons; STB Date

Pump Tank: Gallons; PT Date

Pump Make: Model Serial No.

Nitrification Field: No Fields 1 Square Feet 510 Linear Feet 170

No Lines ONE Trench Width 36" Max Trench Bottom Depth 36" Gravel Depth 12"

☐ New System ☑ Repair System Type: I, II, III, IV, V, VI

System Description:

Repair System Description: CONVENTIONAL GRAVITY

Maintenance Agreement Required: ☐ Yes ☒ No

☐ House/Mod. Home No. Bedrooms

☐ Mobile Home No. Bathrooms

☐ Business No. Employees

☐ Other


☐ Slab ☒ Crawl Space ☐ Basement w/plumbing ☐ Basement wo/plumbing

Water Supply: ☑ Individual ☐ Public ☐ Community 2" WELL

Comments/Conditions: ① PUMP-OUT SEPTIC TANK, REPLACE SANITARY TEE IF NECESSARY ② INSTALL NEW DIST. BOX AT LOCATION SHOWN ③ INSTALL NEW 3"x 170' LINE AS FLAGGED

Comments/Conditions: ① SANITARY TEE REPLACED ② TANK PUMPED 2-9-98

INITIAL SITE SKETCH

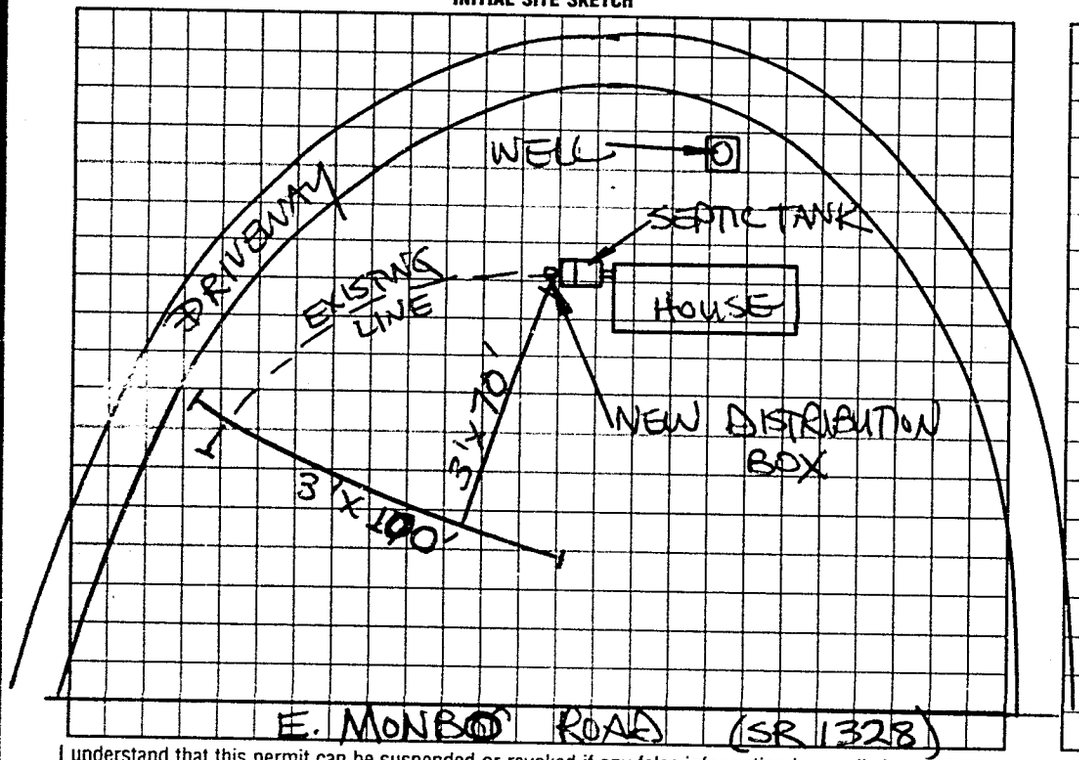

AS BUILT SKETCH

SYSTEM REPAIRED ACCORDING TO INITAL SITE SKETCH

I understand that this permit can be suspended or revoked if any false information is supplied toward securing the permit/any unauthorized changes are made to the site/any unauthorized changes are made in the installation of the system. Improvement Permit with plat valid without expiration. Improvement Permit with site plan valid for sixty months. Authorization to Construct is valid for a period equal to that of Improvement Permit – not to exceed sixty months.

Signed: X Bob Sherrill date 1-16-98

Improvement Permit by: STEVE HEDRICK date 1-16-98

Authorization to Construct by: STEVE HEDRICK date 1-16-98

Installed by: WAYNE CLONTZ

Operation Permit by: STEVE HEDRICK date 2-9-98

Existing System Inspection by date

HEALTH DEPT COPY: WHITE INSPECTION COPY (FINAL): GREEN OWNER COPY (FINAL): YELLOW INSPECTION COPY (INITIAL): PINK OWNER COPY (INITIAL): GOLD