IREDELL COUNTY HEALTH DEPARTMENT

STATESVILLE 704-878-5305 MOORESVILLE 704-664-5281

IMPROVEMENT PERMIT / AUTHORIZATION TO CONSTRUCT / OPERATION PERMIT / EXISTING SYSTEM INSPECTION

PERMIT# 134488 PIN# 4721619295 DATE 3-22-10

OWNER OR CONTRACTOR Chris Shaw PHONE: Business 704-902-0884 Home

ADDRESS 746 Oswalt Mill RD. Statesman NC. 28160

LOCATION I-40W Onto TL EAST-Mondo TR 1/4-1/2 mile past High ave on left

SUBDIVISION BLOCK / SECTION LOT LOT AREA 2.06 SITE CLASS. B DESIGN FLOW 450 L.T.A.R. 13

Septic Tank: 1000 Gallons; STB 1000 Date 7-13-00

Pump Tank: Gallons; PT Date

Pump Make: Model Serial No.

Nitrification Field: No Fields Square Feet 1600 Linear Feet 400

No Lines 4 Trench Width 36 Max Trench Bottom Depth 36 Gravel Depth N/A

☐ New System ☐ Repair System Type: I, II, III, IV, V, VI

System Description: 25% GRADE

Repair System Description: 25% GRADE

Maintenance Agreement Required: ☐ Yes ☑ No

☑ House/Mod. Home No. Bedrooms 4

☐ Mobile Home No. Bathrooms

☐ Business No. Employees

☐ Other


☐ Slab ☐ Crawl Space ☑ Basement w/plumbing ☐ Basement wo/plumbing

Water Supply: ☐ Individual ☐ Public ☐ Community

Comments:/Conditions:

(NOT to SCALE)

INITIAL SITE SKETCH

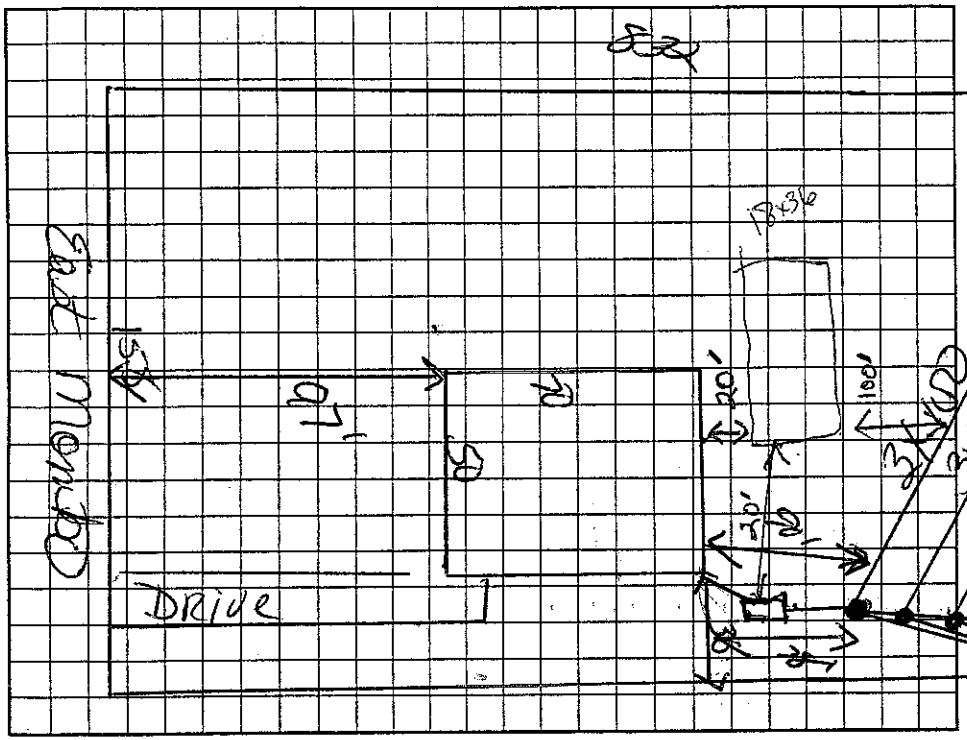

Comments:/Conditions:

Screen sides of trenches

Install on Contour

Maintain all setbacks

AS BUILT SKETCH

Well must be 100' away from system and Repair

Septic tank must be Bio/Range BUW60 filter

The proposed in ground pool addition does not appear to impact the existing septic system.

**NOTE:

R.S.

Date: 4-21-10

ICHD-Environmental Health Division

Permit can be suspended or revoked if any false information is supplied toward securing the permit/any unauthorized changes are made to the site/any unauthorized changes are made in the installation of the system. Improvement Permit with plat valid without expiration. Improvement Permit with site plan valid for sixty months. Authorization to Construct is valid for a period equal to that of Improvement Permit – not to exceed sixty months.

Signed: date

Improvement Permit by: date 3-22-10

Authorization to Construct by: date 3-22-10

Installed by: JAMES Hudden

Operation Permit by: date 9-12-06

Existing System Inspection by: date

HEALTH DEPT. COPY: WHITE OWNER COPY (FINAL): YELLOW OWNER COPY (INITIAL): PINK