IREDELL COUNTY HEALTH DEPARTMENT

STATESVILLE 704-878-5305 (C1) MOORESVILLE 704-664-5281

IMPROVEMENT PERMIT / AUTHORIZATION TO CONSTRUCT / OPERATION PERMIT / EXISTING SYSTEM INSPECTION

PERMIT# 129350 PIN# 4721647791 M41374 DATE 7-20-05

OWNER OR CONTRACTOR Chris Ostwalt PHONE: Business 704-528-4060 Home 704-528-1291

ADDRESS 497 Lytton St. Troutman

LOCATION Old Mountion Rd, turn on E. Monbo, 1.5 mi. on right, 548 E. Monbo Rd.

SUBDIVISION _____ BLOCK / SECTION _____ LOT _____ LOT AREA 3.0 Ac SITE CLASS. PS DESIGN FLOW 480 L.T.A.R. .3

Septic Tank: 1000 Gallons: STB 1012 Date 11-29-05
Pump Tank: _____ Gallons; PT _____ Date _____
Pump Make: _____ Model _____ Serial No. _____
Nitrification Field: No Fields ___ Square Feet 1600 Linear Feet 534
No Lines 5 Trench Width 36" Max Trench Bottom Depth 36" Gravel Depth 12"

☒ New System ☐ Repair System Type: I, II, III, IV, V, VI
System Description: Conv. gravity
Repair System Description: 25% red.
Maintenance Agreement Required: ☐ Yes ☒ No


☒ House/Mod. Home No. Bedrooms 4
☐ Mobile Home No. Bathrooms ___
☐ Business No. Employees ___
☐ Other _____
☐ Slab ☐ Crawl Space ☐ Basement w/plumbing ☒ Basement wo/plumbing

Water Supply: ☒ Individual ☐ Public ☐ Community

Comments:/Conditions:
An accepted system may also be used.
System to be at least 10 ft. from property line.
Septic tank must be at least 15 ft. from house foundation

Comments:/Conditions: SEPTIC TANK WITH MARKER INSTALLED
USING "TUFTITE" FILTER

INITIAL SITE SKETCH

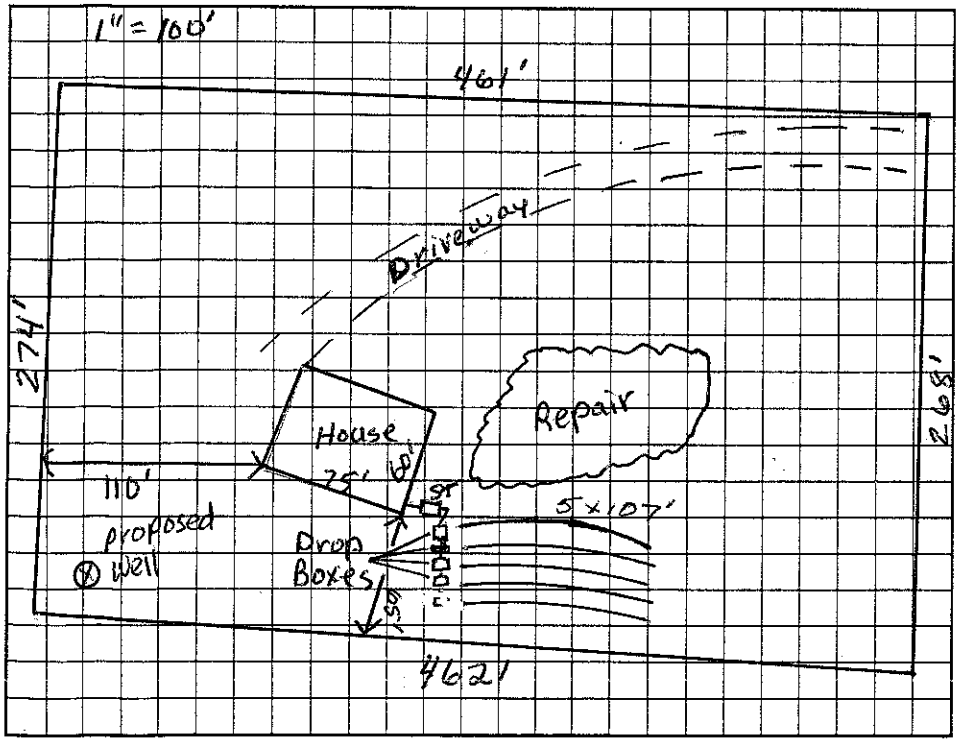

AS BUILT SKETCH

SYSTEM INSTALLED ACCORDING TO INITIAL SITE SKETCH

Permit can be suspended or revoked if any false information is supplied toward securing the permit/any unauthorized changes are made to the site/any unauthorized changes are made in the installation of the system. Improvement Permit with plat valid without expiration. Improvement Permit with site plan valid for sixty months. Authorization to Construct is valid for a period equal to that of Improvement Permit – not to exceed sixty months.

Signed: Christopher N. Ostwalt date 7-25-05
Improvement Permit by: Judy Melville date 7-20-05
Authorization to Construct by: Judy Melville date 7-20-05

Installed by: A-1 BACKHOE
Operation Permit by: STEVE HEDRICK date 3-9-06
Existing System Inspection by: _____ date _____

HEALTH DEPT. COPY: WHITE OWNER COPY (FINAL): YELLOW OWNER COPY (INITIAL): PINK