IREDELL COUNTY HEALTH DEPARTMENT

STATESVILLE 704-878-5305 MOORESVILLE 704-664-5281

IMPROVEMENT PERMIT / AUTHORIZATION TO CONSTRUCT / OPERATION PERMIT / EXISTING SYSTEM INSPECTION

(D)

PERMIT# 144283 PIN# ~~4721-80-8656 (PT)~~ 4721-80-8590 DATE 8-9-07

OWNER OR APPLICANT H. KENT SHAW PHONE: Business 704-902-0085 Home 704-528-4421

ADDRESS P.O. BOX 1061 TROUTMAN, NC 28166-1061

LOCATION OLD MTN. RD TO E. MONBO ROAD, TL, HICKS CREEK RD. 0.5 MILE ON RIGHT

SUBDIVISION SHAW BLOCK / SECTION ____ LOT 2 LOT AREA (PT) 3.921 ACRES SITE CLASS. PS DESIGN FLOW 480 L.T.A.R. 0.30 GPD/FT2

Septic Tank: 1000 Gallons; STB 1012-1000 Date 5-22-07

Pump Tank: ____ Gallons; PT ____ Date ____

Pump Make: ____ Model ____ Serial No. ____

Nitrification Field: No Fields 1 Square Feet EQ. TO 1600 Linear Feet 400

No Lines THREE Trench Width 36" Max Trench Bottom Depth 36" Gravel Depth N/A

☑ New System ☐ Repair ☐ Expansion System Type: I II III IV V VI

System Description: 25% REDUCTION SYSTEM

Repair System Description: 25% REDUCTION SYSTEM

Maintenance Agreement Required: ☑ Yes ☐ No

☑ Gravity ☐ Pressure

☑ House/Mod. Home ☐ Mobile Home ☐ Business ☐ Other

No. Bedrooms 4 No. Persons ____ No. Employees ____


☐ Slab ☑ Crawl Space ☐ Basement w/plumbing ☐ Basement wo/plumbing

Water Supply: ☐ Individual ☑ Public ☐ Community


Comments/Conditions: INSTALL 25% ~~GRAVITY~~ REDUCTION SYSTEM ON CONTOUR AS FLAGGED ON SITE

Comments/Conditions:

INITIAL SITE SKETCH

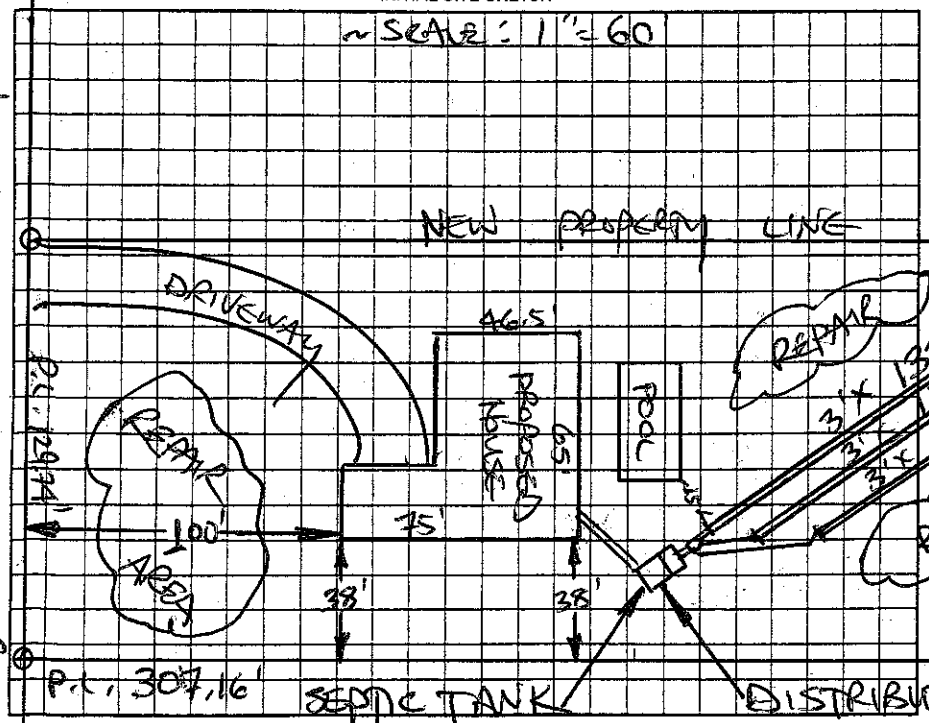

AS BUILT SKETCH

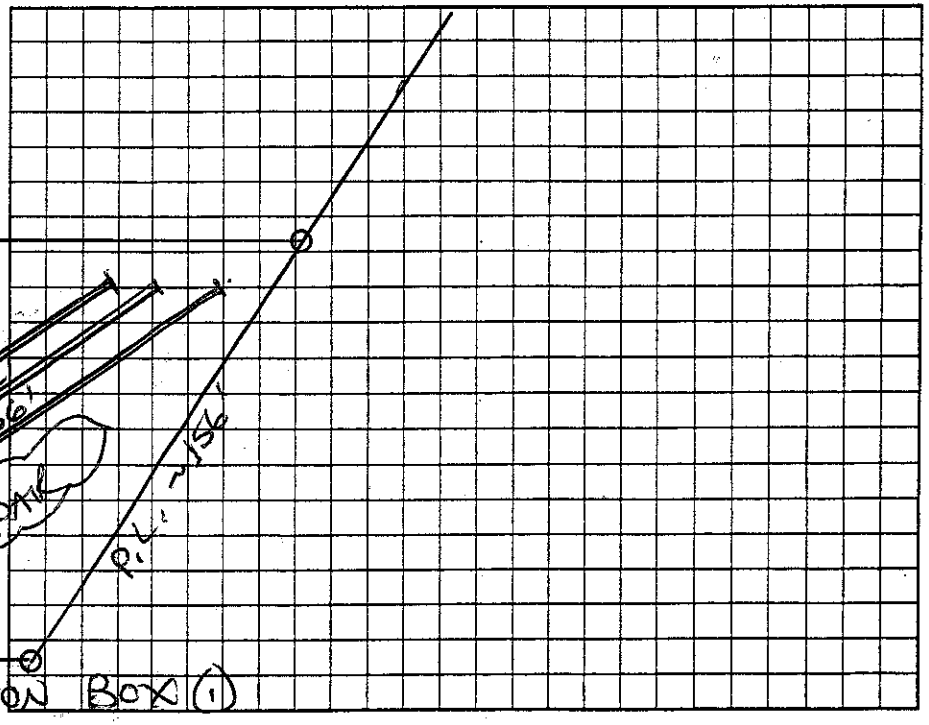

HICKS CREEK ROAD (SR 1322)

Permit can be suspended or revoked if any false information is supplied toward securing the permit/any unauthorized changes are made to the site/any unauthorized changes are made in the installation of the system. Improvement Permit with plat valid without expiration ☐ Improvement Permit with site plan valid for sixty months ☑ Authorization to Construct is valid for a period equal to that of Improvement Permit – not to exceed sixty months.

Signed: H. Kent Shaw date 8-9-07 Installed by: Chris Thompson

Improvement Permit by: STEVE HEDRICK date 8-9-07 Operation Permit by: [signature] date JAN-8-08

Authorization to Construct by: STEVE HEDRICK date 8-9-07 Existing System Inspection by: ____ date ____

HEALTH DEPT. COPY: WHITE OWNER COPY (FINAL): YELLOW OWNER COPY (INITIAL): PINK