IREDELL COUNTY HEALTH DEPARTMENT

STATESVILLE 704-878-5305 MOORESVILLE 704-664-5281

IMPROVEMENT PERMIT / AUTHORIZATION TO CONSTRUCT / OPERATION PERMIT / EXISTING SYSTEM INSPECTION

PERMIT# 073654 PIN# 4727 81 1576 DATE 6-3-98

OWNER OR CONTRACTOR FRANK SHERRILL PHONE: Business Home 872-0922

ADDRESS 651 E. MONBO ROAD, STATESVILLE, NC 28677

LOCATION I-40 W, TL OLD MTN. RD, TR E. MONBO ROAD, ON LEFT 0.2 MILE PAST HICKS CREEK ROAD AT BOX #651

SUBDIVISION BLOCK / SECTION LOT LOT AREA 15.00 ACRES SITE CLASS. PS DESIGN FLOW 480 L.T.A.R. 0.30 GPD/FT²

Septic Tank: EXISTING Gallons; STB Date

Pump Tank: Gallons; PT Date

Pump Make: Model Serial No.

Nitrification Field: No Fields 1 Square Feet EQ TO 252 Linear Feet ~ 84+

No Lines FOUR Trench Width 36" Max Trench Bottom Depth 36"

☑ New System ☐ Repair System Type: I, II, (III), IV, V, VI

System Description: CHAMBERED GRAVITY

Repair System Description: LOW PRESSURE PIPE

Maintenance Agreement Required: ☐ Yes ☑ No

Gravel Depth 3 AND 6"

☑ House/Mod. Home No. Bedrooms 4

☐ Mobile Home No. Bathrooms 3

☐ Business No. Employees

☐ Other


☐ Slab ☑ Crawl Space ☐ Basement w/plumbing ☐ Basement wo/plumbing

Water Supply: ☑ Individual ☐ Public ☐ Community


Comments:/Conditions: INSTALL FOURTEEN (14) CHAMBERS ATTACHING TO EXISTING CHAMBERS AS SHOWN USING FIVE (5) ON LOWEST LINE,

Comments:/Conditions: S/W MH TO BE REMOVED UPON OCCUPANCY OF HOUSE

INITIAL SITE SKETCH

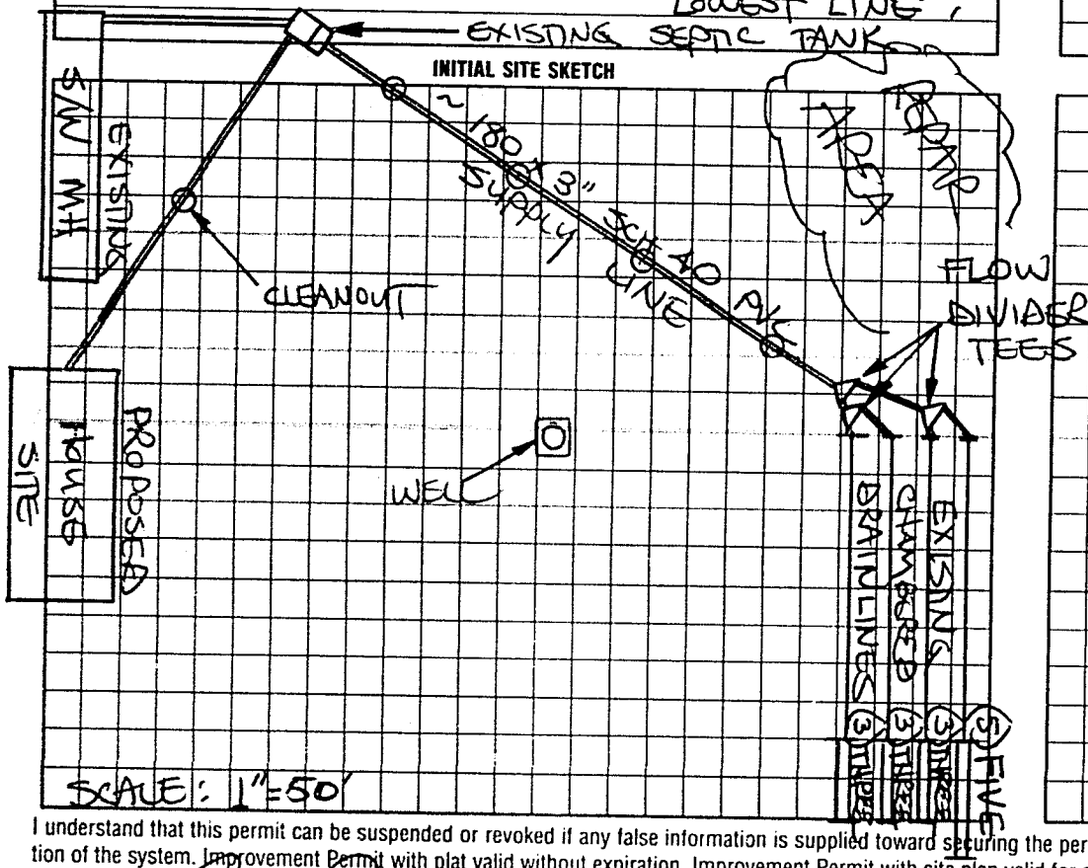

AS BUILT SKETCH

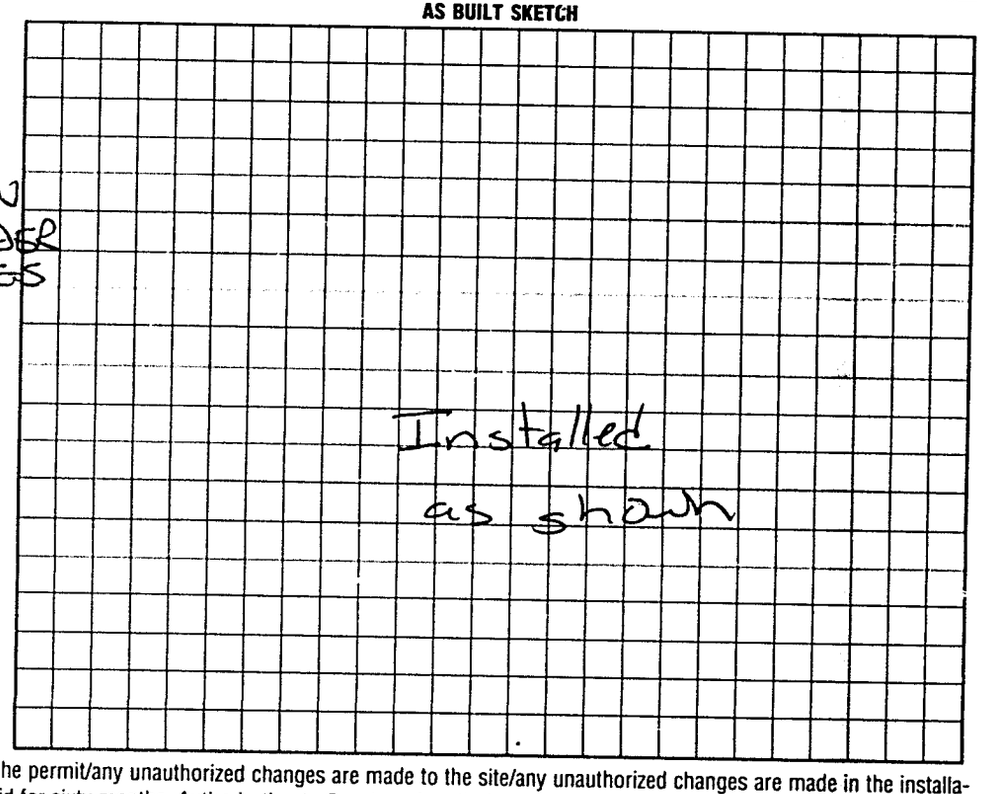

I understand that this permit can be suspended or revoked if any false information is supplied toward securing the permit/any unauthorized changes are made to the site/any unauthorized changes are made in the installation of the system. Improvement Permit with plat valid without expiration. Improvement Permit with site plan valid for sixty months. Authorization to Construct is valid for a period equal to that of Improvement Permit – not to exceed sixty months.

Signed: [signature] date 6/4/98

Improvement Permit by: STEVE HEDRICK date 6-3-98

Authorization to Construct by: STEVE HEDRICK date 6-3-98

Installed by: Tommy Frye

Operation Permit by: Mat Coutts date 8-4-98

Existing System Inspection by date

HEALTH DEPT COPY: WHITE INSPECTION COPY (FINAL): GREEN OWNER COPY (FINAL): YELLOW INSPECTION COPY (INITIAL): PINK OWNER COPY (INITIAL): GOLD