9:30

IREDELL COUNTY HEALTH DEPARTMENT

STATESVILLE 704-878-5305 MOORESVILLE 704-664-5281

IMPROVEMENT PERMIT / CERTIFICATE OF COMPLETION / OPERATION PERMIT / EXISTING SYSTEM INSPECTION

PROPERTY DESCRIPTION NO. 67775 DATE 6-23-97 TAX MAP NO. 4721827514 Watershed: ☑ Yes ☐ No

OWNER OR CONTRACTOR Edwart Jim & Coy Sr PHONE: Business Home (704-528-4099) WSIV-PA

ADDRESS 625 East Monbo RJ

LOCATION off mtn Rd Turn East monbo TL Hicks Creek 1st Hse on Rt

SUBDIVISION BLOCK / SECTION LOT LOT AREA SITE CLASS. PS DESIGN FLOW 480 L.T.A.R. .3

Septic Tank: 1060 Gallons; STB 1012 Date 10-6-97

Pump Tank: Gallons; PT Date

Pump Make: Model Serial No.

Nitrification Field: No Fields 1 Square Feet 1600 Linear Feet 533

No Lines 4 Trench Width 36" Max Trench Bottom Depth 36" Gravel Depth 12"

☑ New System ☐ Repair System Type: I, ☒ III, IV, V, VI

System Description: Conv. Gravity

Repair System Description: " "

Maintenance Agreement Required: ☐ Yes ☐ No

☑ House/Mod. Home No. Bedrooms 4

☐ Mobile Home No. Bathrooms 3

☐ Business No. Employees

☐ Other


☐ Slab ☑ Crawl Space ☐ Basement w/plumbing ☐ Basement wo/plumbing

Water Supply: ☑ Individual ☐ Community ☐ Public Well

Comments:

Comments:

INITIAL SITE SXETCH

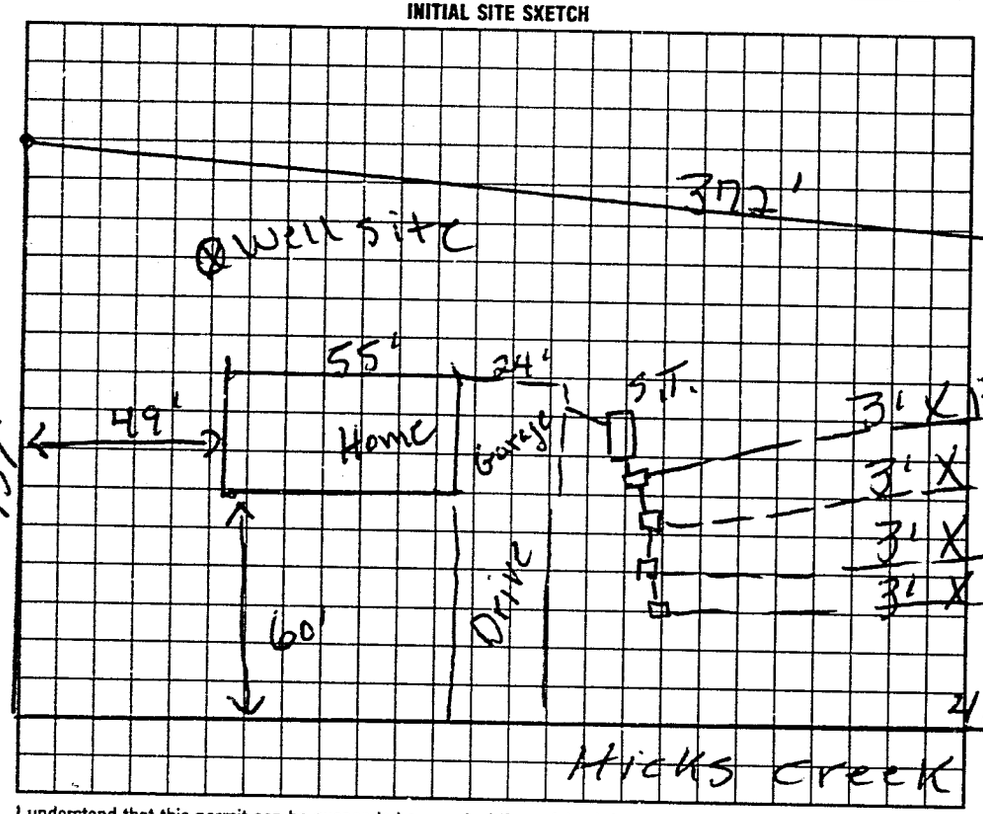

AS BUILT SKETCH

Same as initial sketch.

I understand that this permit can be suspended or revoked if any false information is supplied toward securing the permit/any unauthorized changes are made to the site/any unauthorized changes are made in the installation of the system. Improvement Permit is valid for 60 months from date of issuance.

Signed: X Bonnetta Sikkela

Improvement Permit by: P. C. Moore date 6-23-97

Authorization to Existing System Inspection by: P. C. Moore date 6-23-97

+0 Count

Installed by: A-1 Backhoe

Certificate of Completion by: date

Operation Permit by: P. C. Moore date 1-30-98

HEALTH DEPT COPY: WHITE INSPECTION COPY (FINAL): GREEN OWNER COPY (FINAL): YELLOW INSPECTION COPY (INITIAL): PINK OWNER COPY (INITIAL): GOLD

Authorization to count EXPIRES 60 mos FROM ISSUE

8 1 9 2 0