IREDELL COUNTY HEALTH DEPARTMENT

Statesville Phone TR 3-7271 Mooresville Phone NO 3-1271

PERMIT TO INSTALL SEPTIC TANK

Permit NO. _____ Permit Date June 19 61

Owner Gordon Troutman Jr. Address _____

Installed By B.C Ostwalt Address _____


Location of Property East Monbo, Road

Tank		Capacity		Length of Lines		Fixtures	
Block	(✓)	800	( )	150'	( )	No. of Baths	( )
Precast	( )	900	( )	175'	( )	Dishwasher	( )
		1000	(✓)	200'	( )	Garbage Grdr.	( )
		1100	( )	225'	(✓)	Auto-Washer	( )
		1200	( )	250'	( )	Other	
		Other		Other			

NOTIFY HEALTH DEPARTMENT AT LEAST EIGHT HOURS BEFORE TANK IS TO BE INSPECTED.

Final Inspection 6 1961 Approved (✓) Disapproved ( )

Remarks _____

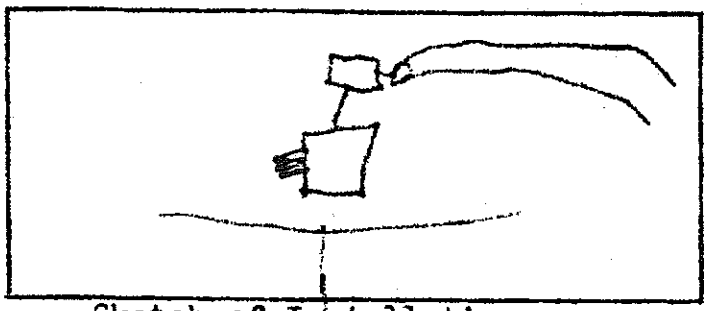

Sketch of Installation

The location of the proposed COVERED DECK addition does not appear to impact the existing septic system.

**NOTE: _____

R. STEVE HEDRICK REHS

Date: 12-15-2010

ICHD-Environmental Health Division

Sanitarian