IREDELL COUNTY HEALTH DEPARTMENT

STATESVILLE 704-878-5305 (CI) MOORESVILLE 704-664-5281

IMPROVEMENT PERMIT / AUTHORIZATION TO CONSTRUCT / OPERATION PERMIT / EXISTING SYSTEM INSPECTION

PERMIT # 155645 PIN # 4721862609 DATE 4-15-09

OWNER or APPLICANT BRENT WARREN PHONE: Business 704-902-4618 Home: 704-528-5989

OWNER or APPLICANT ADDRESS 422 EAST MONRO Troutman NC 28166

LOCATION / DIRECTIONS 21 SOUTH, (2) ONR (3) EAST MONRO (4) AT BOX # 422 PAST HORSE FARM FENCE, Gravel ROAD VERY LONG AT END

SUBDIVISION BLOCK / SECTION LOT # LOT AREA 8.12 AC DESIGN FLOW 360 L.T.A.R. .25

Septic Tank 1000 Gallons: STB 1012 Date 3-16-09
Pump Tank Gallons: P T Date
Pump Make Model Serial #
Nitrification Field No Fields 1 No Lines 4 Linear Feet 360'
Trench Width 36" Max. Trench Bottom Depth 24" Gravel Depth N/A

☒ New System ☐ Repair ☐ Expansion System Type I II (III) IV V VI
System Description: GRAVITY 25% REDUCTION
Repair System Description: GRAVITY CONVENTIONAL
Maintenance Agreement Required ☐ YES ☒ NO
☒ GRAVITY ☐ PRESSURE

☒ Residence No. Bedrooms 3
☐ Business No. Persons 2
☐ Other No. Employees
☐ Slab ☒ Crawl Space
☐ Basement w/plumbing ☐ Basement w/o plumbing

Water Supply: ☒ Private ☐ Public ☐ Community

Comments / Conditions (1) NOTE MAXIMUM TRENCH BOTTOM DEPTH OF 24" (2) See Notes on Abandoning Old System (3) Install lines on contours & maintain Setbacks. (4) Builder Requests 25% REDUCTION

Comments / Conditions

INITIAL SITE SKETCH

SEE ATTACHED SYSTEM DESIGN BY LORNE COOK, R.S.

AS BUILT SKETCH

- SEPTIC TANK INSTALLED WITH POLYLOK FILTER
- INSTALLED AS ENDCAP DISTRIBUTION

Permit can be suspended or revoked if any false information is supplied toward securing the permit / any unauthorized changes are made to the site / any unauthorized changes are made in the installation of the system.

☐ *IMPROVEMENT PERMIT w / plat valid without expiration.* ☒ *IMPROVEMENT PERMIT w / site plan valid for 60 mos.* ☒ *AUTHORIZATION TO CONSTRUCT valid for period equal to IMPROVEMENT PERMIT-not to exceed 60 mo.*

Owner / Applicant Signature: Date 4/20/09

Improvement Permit by: Date 4-15-09

Authorization to Construct by: Date 4-15-09

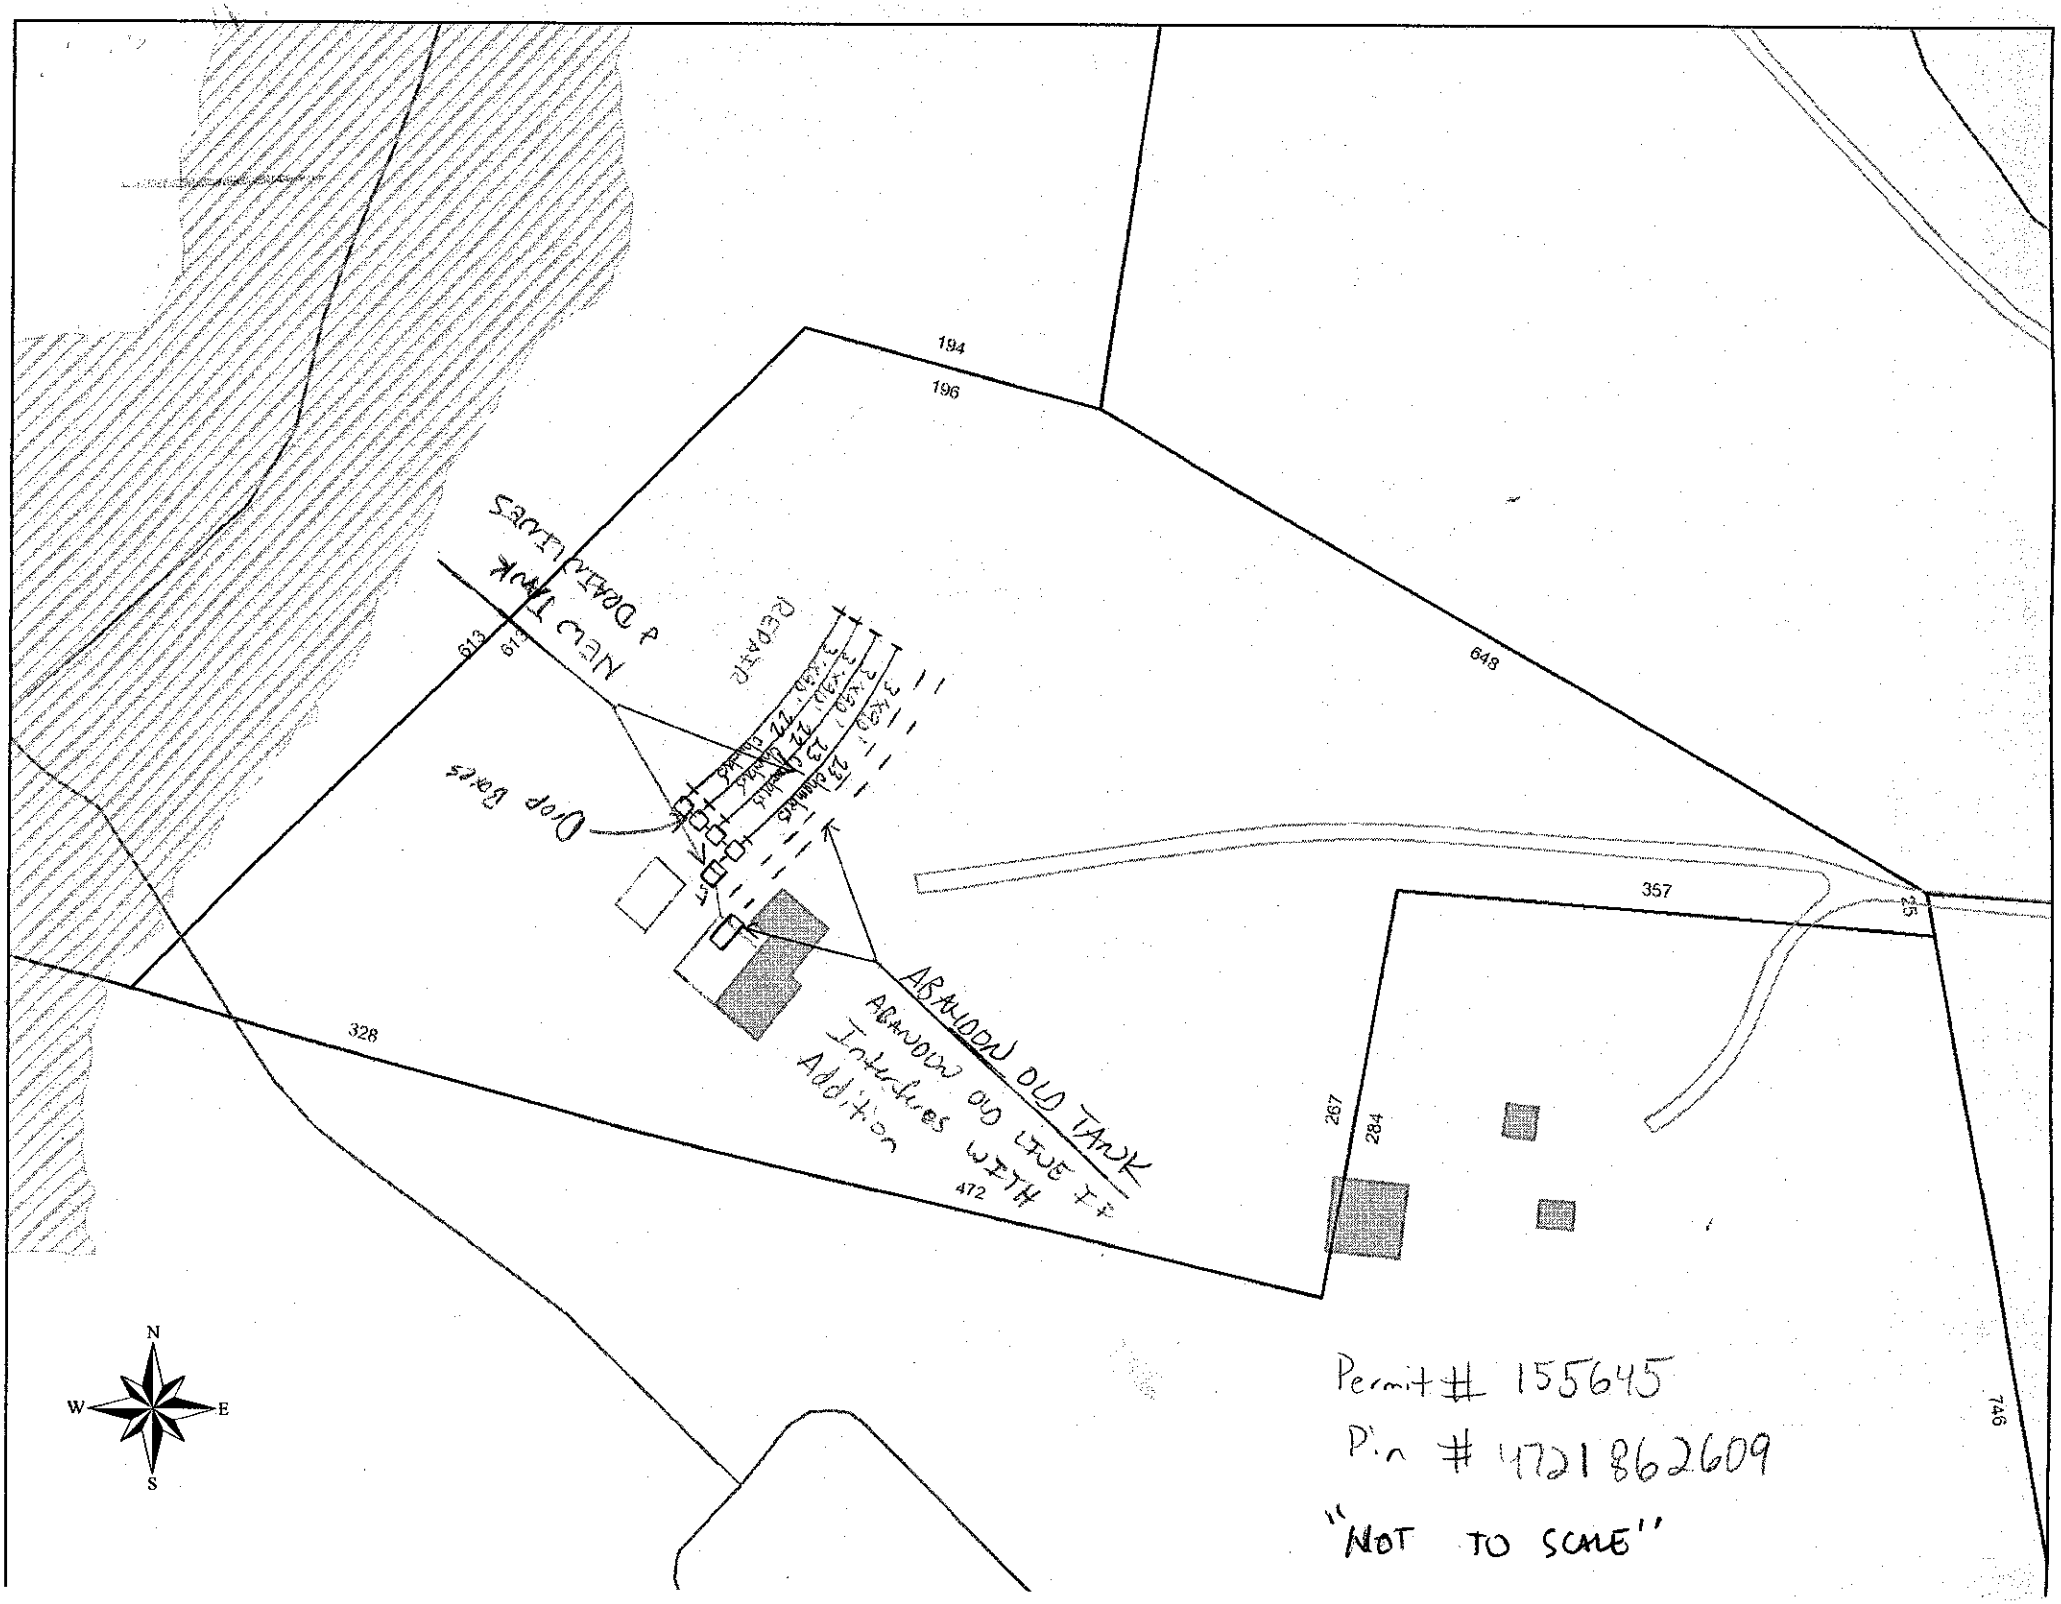
Installed by: Piedmont Backhoe

Operation Permit by: Date: 5-13-09

Existing System Inspected by: Date:

YOU SHOULD CONTACT A LOCATOR SERVICE PRIOR TO ANY EXCAVATION.

WHITE COPY Environmental Health YELLOW COPY (Final) Owner / Applicant PINK COPY (Initial) Owner / Applicant


194
196
648
357
328
267
284
472
746
Permit # 155645
Pin # 1721862609
"NOT TO SCALE"