IREDELL COUNTY HEALTH DEPARTMENT

STATESVILLE 704-878-5305 MOORESVILLE 704-664-5281

IMPROVEMENT PERMIT / AUTHORIZATION TO CONSTRUCT / OPERATION PERMIT / EXISTING SYSTEM INSPECTION

PERMIT# REPAIR PIN# 4721-90-8998 DATE 10-29-03

OWNER OR CONTRACTOR MARGARET KERLEY WILLIAMS PHONE: Business Home 704-528-0086

ADDRESS 201 HICKS CREEK RD, TROUTMAN, NC 28166

LOCATION EAST MONGO ROAD TO HICKS CREEK ROAD, ON LEFT AT BOX # 201

SUBDIVISION BLOCK / SECTION LOT LOT AREA 5.52 ACRES SITE CLASS. PS DESIGN FLOW 240 L.T.A.R. EXISTING

Septic Tank: EXISTING Gallons: STB Date

Pump Tank: Gallons: PT Date

Pump Make: Model Serial No.

Nitrification Field: No Fields 1 Square Feet 150 Linear Feet 50

No Lines ONE Trench Width 36" Max Trench Bottom Depth 36" Gravel Depth 24"

☐ New System ☑ Repair System Type: I, II, III, IV, V, VI

System Description: CONVENTIONAL, GRAVITY

Repair System Description: CONVENTIONAL, GRAVITY

Maintenance Agreement Required: ☐ Yes ☑ No

☑ House/Mod. Home No. Bedrooms 2

☐ Mobile Home No. Bathrooms 1

☐ Business No. Employees

☐ Other


☐ Slab ☑ Crawl Space ☐ Basement w/plumbing ☐ Basement wo/plumbing

Water Supply: ☑ Individual ☐ Public ☐ Community

Comments:/Conditions: EXCAVATE EXISTING DRAINLINE 5' FEET FROM PROPERTY LINE & FILL WITH CLEAN CLAY. REPLACE ABANDONED DRAINLINE WITH NEW 3'x50' DRAINLINE USING 24" STONE

Comments:/Conditions:

INITIAL SITE SKETCH

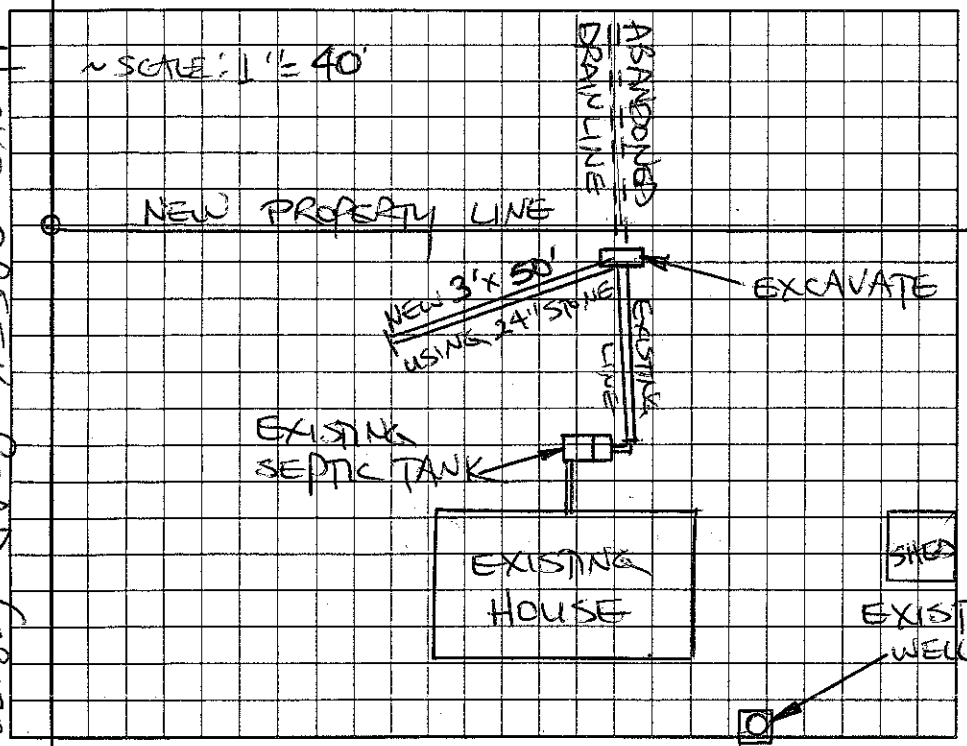

AS BUILT SKETCH

SYSTEM RELOCATED ACCORDING TO INITAL SITE SKETCH

Permit can be suspended or revoked if any false information is supplied toward securing the permit/any unauthorized changes are made to the site/any unauthorized changes are made in the installation of the system. Improvement Permit with plat valid without expiration. Improvement Permit with site plan valid for sixty months. Authorization to Construct is valid for a period equal to that of Improvement Permit -- not to exceed sixty months.

Signed: Margaret Kerley Williams date Installed by: A-1 BACKHOE

Improvement Permit by: STEVE HEDRICK date 10-29-03 Operation Permit by: STEVE HEDRICK date 6-1-04

Authorization to Construct by: STEVE HEDRICK date 10-29-03 Existing System Inspection by: date

HEALTH DEPT. COPY: WHITE OWNER COPY (FINAL): YELLOW OWNER COPY (INITIAL): PINK