IREDELL COUNTY HEALTH DEPARTMENT

STATESVILLE 704-878-5305 MOORESVILLE 704-664-5281

IMPROVEMENT PERMIT / CERTIFICATE OF COMPLETION / OPERATION PERMIT / EXISTING SYSTEM INSPECTION

PROPERTY DESCRIPTION NO. 18770 DATE 7-29-94 TAX MAP NO. 3E-A-45 Watershed: ☐ Yes ☑ No

OWNER OR CONTRACTOR Charles M. Fox PHONE: Business _____ Home 528-0821

ADDRESS 29 Spicewood Circle Troutman, N.C. 28166

LOCATION I40W TL Old Mtn. Rd TR East Mombo Rd TL Hick Creek Rd. lot ≈.6 mile on L back off in woods.

SUBDIVISION NA BLOCK / SECTION NA LOT NA LOT AREA 7.0 acres SITE CLASS. P.S. DESIGN FLOW 360 L.T.A.R. .3 gpd/ft²

Septic Tank: 1000 Gallons; STB 794 Date 6-9-94
Pump Tank: — Gallons; PT — Date —
Pump Make: — Model — Serial No. —
Nitrification Field: No Fields 1 Square Feet 1200 Linear Feet 400'
No Lines 3 Trench Width 36" Max Trench Bottom Depth 22"

☑ New System ☐ Repair System Type: I, II, III, IV, V, VI
System Description: Conventional, gravity fed
Repair System Description: "
Maintenance Agreement Required: ☐ Yes ☑ No
Gravel Depth 12"


☐ House/Mod. Home No. Bedrooms 2
☑ Mobile Home No. Bathrooms 2
☐ Business No. Employees ____
☐ Other ____
☐ Slab ☑ Crawl Space ☐ Basement w/plumbing ☐ Basement wo/plumbing

Water Supply: ☑ Individual ☐ Community ☐ Public

Comments: INSTALL SYSTEM SHALLOW (no deeper than 22" to trench bottom) Keep lines and Trenches on contour. Set tank ≥ 100' from home. Install clean out half way from home to tank. Keep system 100' from well, 10' from all property lines, and keep supply line min. 50' from well.

Comments: Home located 70' from home. O.K.ed by home owner thru contractor. Well not located at time of inspection. Keep well 80' from system and 50' from supply line to system. System only put in for 3 Bedroom home. System sized for future 3 Bedroom House.

INITIAL SITE SKETCH

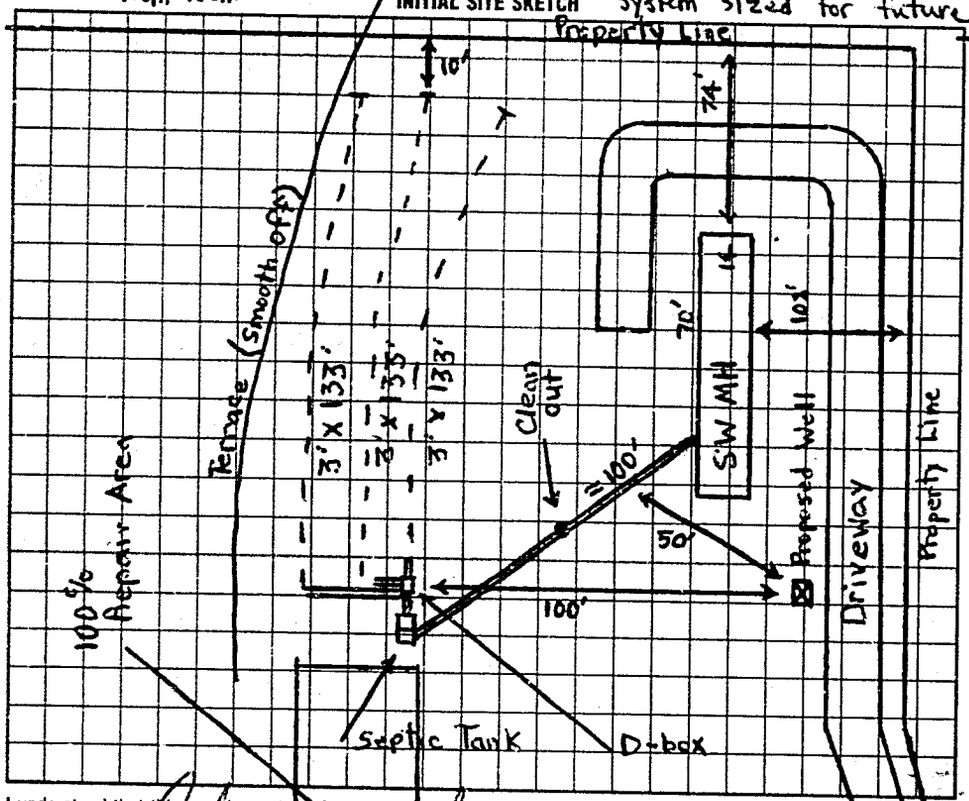


Land owner not sure where house will be located. Will locate house to accomidate system. 100% Repair Area beside system, conventional, gravity fed. Smooth off terrace below septic system.

* System installed for 2 Bedroom Home instead of 3 Bedroom. 240 grd. If future 3 Bedroom home is to be built, extra line will need to be installed.

D-Boxes used as Drop Boxes

AS BUILT SKETCH

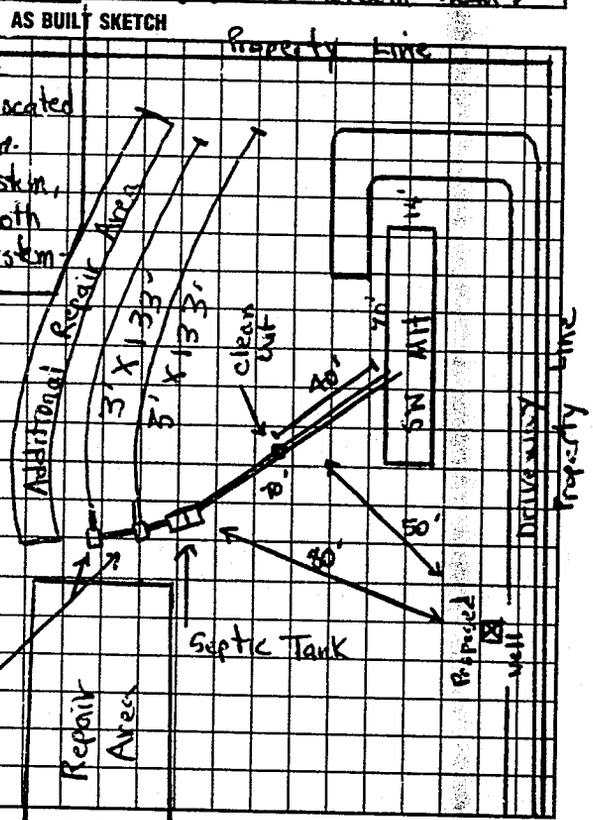

I understand that this permit can be suspended or revoked if any false information is supplied toward securing the permit/any unauthorized changes are made to the site/any unauthorized changes are made in the installation of the system. Improvement Permit is valid for 60 months from date of issuance.

Signed: Charles M. Fox

Improvement Permit by: Michael J. Dennis date 7-29-94

Existing System Inspection by: _____ date _____

Installed by: A-1 Backhoe

Certificate of Completion by: Michael J. Dennis date 8-12-94

Operation Permit by: _____ date _____

HEALTH DEPT. COPY (WHITE) INSPECTION COPY (FINAL) GREEN OWNER COPY (FINAL) YELLOW INSPECTION COPY (INITIAL) PINK OWNER COPY (INITIAL) GOLD