IREDELL COUNTY HEALTH DEPARTMENT

Statesville Phone TR 3-7271 Mooresville Phone NO 3-1271

PERMIT TO INSTALL SEPTIC TANK

Permit No. 145 Permit Date 9-15 19 71

Owner Lathan Estudalt Address Troutman N.C.

Installed By Sam Estudalt Address Troutman N.C.


Location of Property Go out East Monbe Rd at Brown Springs - T.L. on Rd # 1322 - Big house on left.

Tank		Capacity		Length of Lines		Fixtures	
Block	( )	1000	( )	225'	( )	No. of Baths	(3)
Precast	(✓)	1250	(✓)	250'	( )	Dishwasher	(?)
		1500	( )	Other 300'		Garbage Grdr.	(?)
		Other				Other	

NOTIFY HEALTH DEPARTMENT AT LEAST EIGHT HOURS BEFORE TANK IS TO BE INSPECTED.

Final Inspection 9-15 1971 Approved ( ) Disapproved ( )

Remarks Well over 50' away

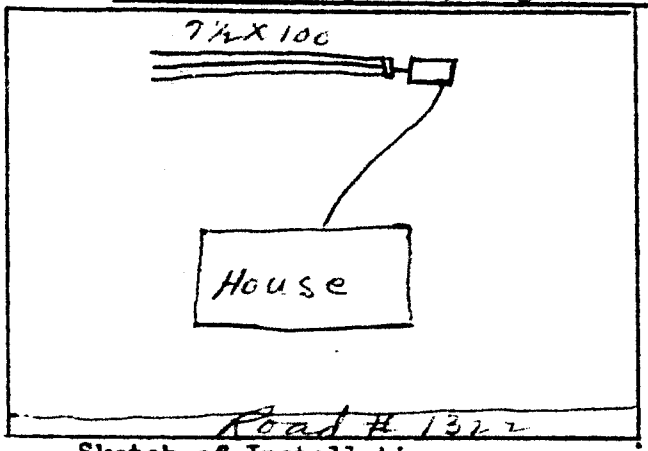

Sketch of Installation

8 inches stone used under lines.
Water from downspout drain should be diverted away from end of lines.
Not Checked

E.G.S.

Sanitarian