IREDELL COUNTY HEALTH DEPARTMENT

STATESVILLE 704-878-5305 MOORESVILLE 704-664-5281

IMPROVEMENT PERMIT / AUTHORIZATION TO CONSTRUCT / OPERATION PERMIT / EXISTING SYSTEM INSPECTION

PERMIT# 14456 6 PIN# 4721916705,001

OWNER OR APPLICANT Perry Mills DATE 8-24-07

ADDRESS PO BOX 1315 Troutman NC 28166 PHONE: Business 704-928-5050 Home

LOCATION 21 South H ② One ① East Monbo ① Hicks Creek ① IW Between BOX # 167 + BOX # 173

SUBDIVISION E. Leon Troutman, JR BLOCK / SECTION LOT 2 LOT AREA 1.108 SITE CLASS. PS DESIGN FLOW 480 L.T.A.R. .3

Septic Tank: 1000 Gallons: STB 82 Date 9-11-07

Pump Tank: Gallons: PT Date

Pump Make: Model Serial No.

Nitrification Field: No Fields 1 Square Feet EO=1600' Linear Feet 400'

No Lines 3X133' Trench Width 36" Max Trench Bottom Depth 36'

☒ New System ☐ Repair ☐ Expansion System Type: I Ⓘ III IV V VI

System Description: Gravity 25% reduction

Repair System Description: Low pressure 50% reduct

Maintenance Agreement Required: ☐ Yes ☒ No

Gravel Depth N/A ☒ Gravity ☐ Pressure ☐ Slab ☒ Crawl Space ☐ Basement w/plumbing ☐ Basement wo/plumbing

☒ House/Mod. Home ☐ Mobile Home ☐ Business ☐ Other

No. Bedrooms 4 No. Persons 8 No. Employees


Water Supply: ☒ Individual ☐ Public ☐ Community

Comments:/Conditions: ① Install Lines on Contours & Maintain Setbacks ② Keep Well 100' Away From Initial System. Space limitations are not encountered here.

Comments:/Conditions: ③ System & House Is completely Flagged OOT 9-14-07 New House Plan Submitted. Putting on 3 Bedroom & System is sized for 4 Bedroom. Polylok Filter & marker

INITIAL SITE SKETCH

AS BUILT SKETCH

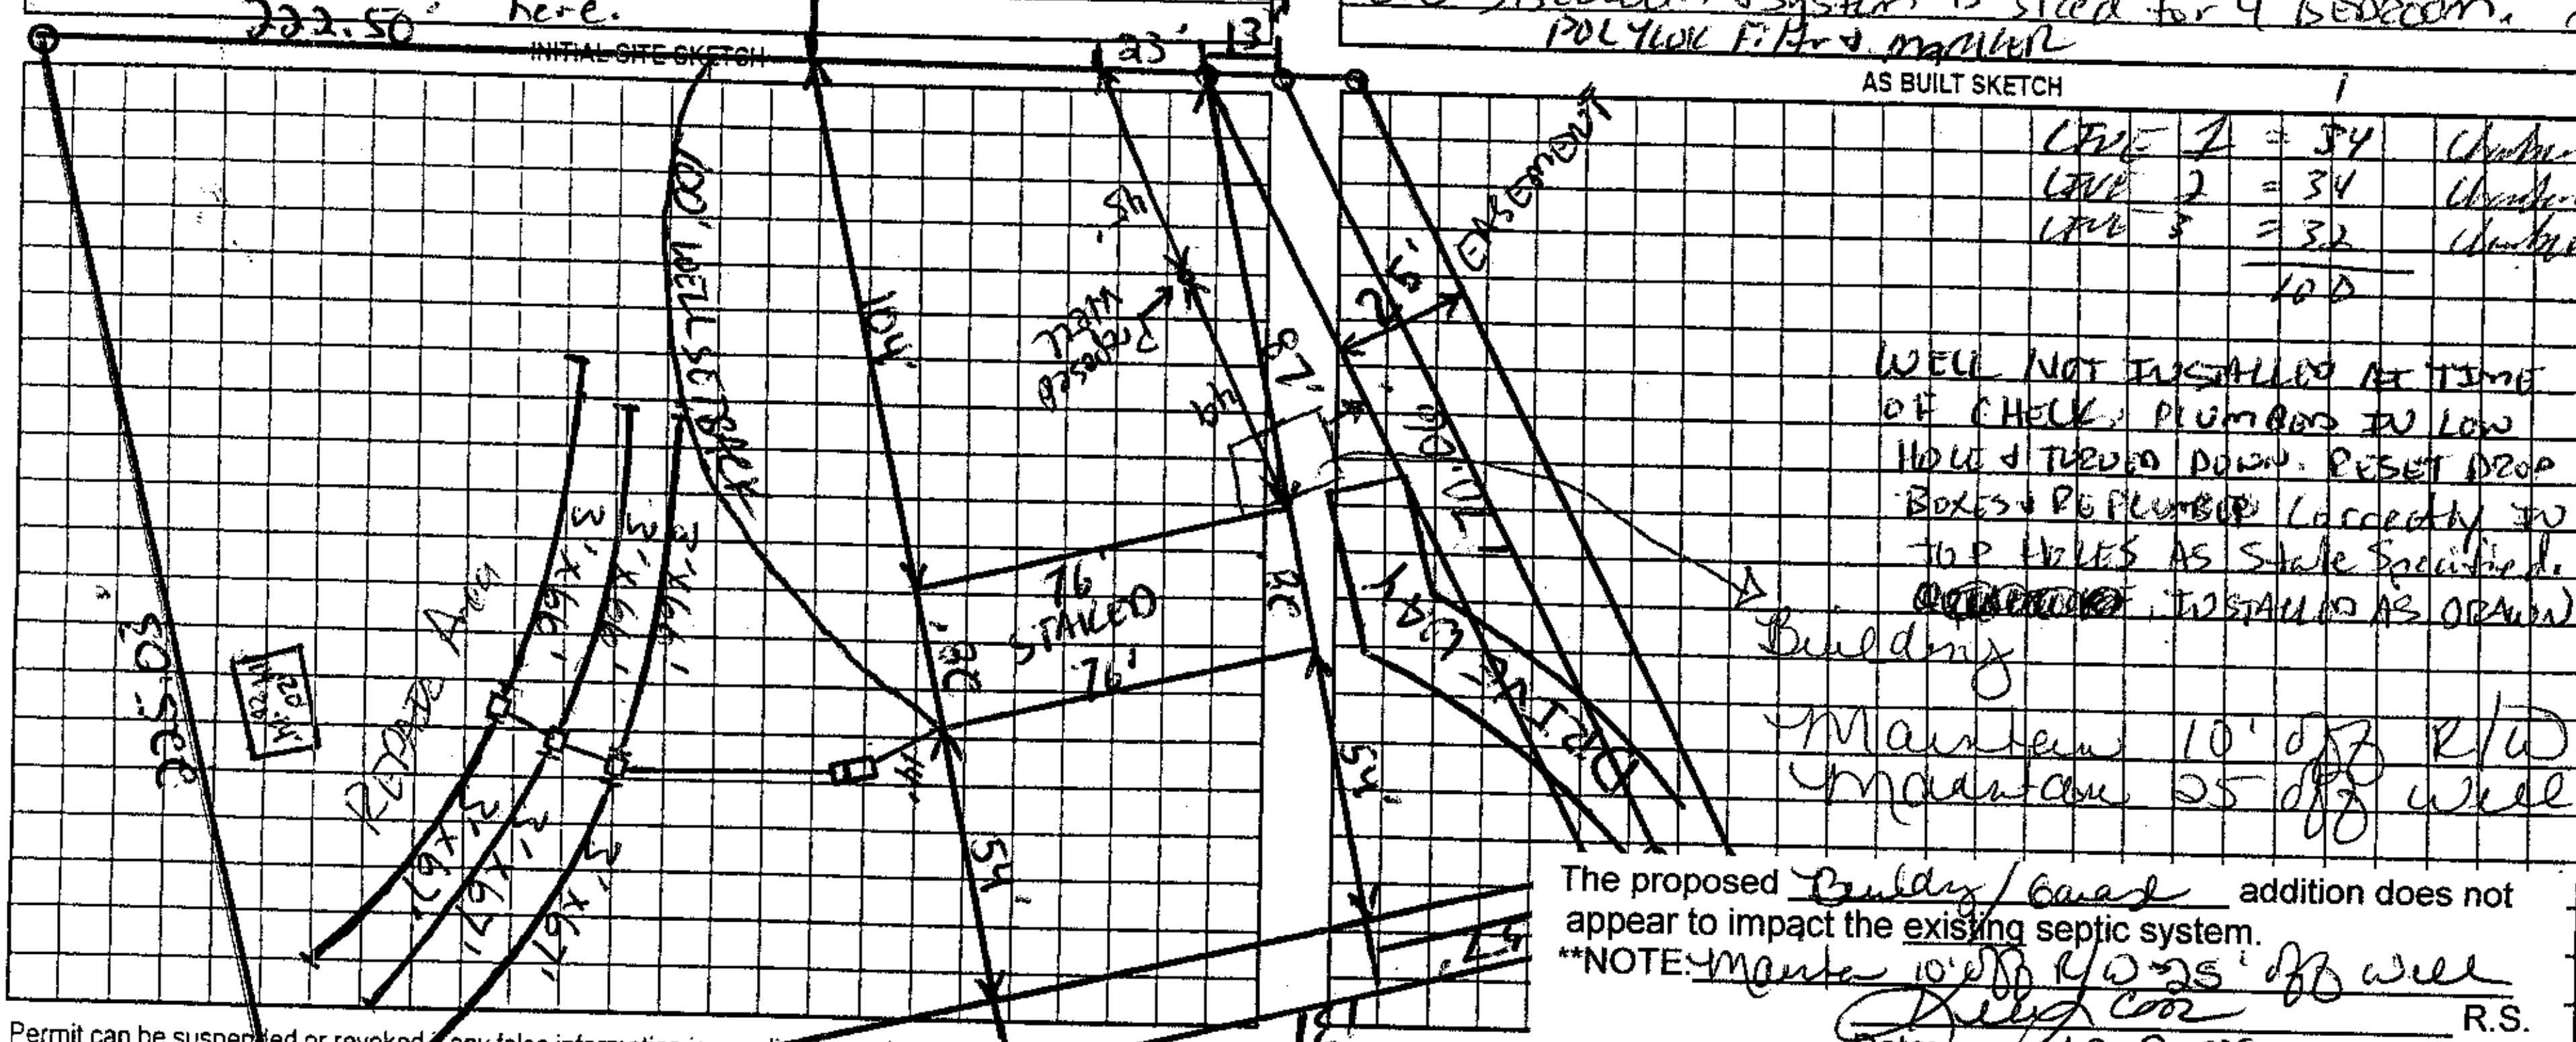

The proposed Buildg / Garage addition does not appear to impact the existing septic system.

**NOTE: Maintain 10' off R/W 25' off well

R.S.

Date: 12-9-09

ICHD-Environmental Health Division

Permit can be suspended or revoked if any false information is supplied toward securing the permit/any unauthorized changes are made

Permit with plat valid without expiration ☐ Improvement Permit with site plan valid for sixty months ☒ Authorization to Construct is valid for a period equal to that of Improvement Permit – not to exceed sixty months.

Signed: Perry Mills date 8-24-07

Improvement Permit by: date 8/24/07

Authorization to Construct by: date 8/24/07

Installed by: Cherryville Grading

Operation Permit by: RS date 10-16-07

Existing System Inspection by: date

HEALTH DEPT. COPY: WHITE OWNER COPY (FINAL): YELLOW OWNER COPY (INITIAL): PINK