IREDELL COUNTY HEALTH DEPARTMENT

STATESVILLE 704-878-5305 MOORESVILLE 704-664-5281

CI 919-301-6029 STEVE [illegible]

IMPROVEMENT PERMIT / AUTHORIZATION TO CONSTRUCT / OPERATION PERMIT / EXISTING SYSTEM INSPECTION

PERMIT# 111743 PIN# 4721-91-9138 DATE 04-15-03

OWNER OR CONTRACTOR DISCOUNT HOMES PHONE: Business 704-480-8484 Home PETE MILLS 704-913-7383

ADDRESS 1606 E. DIXON BLVD SHELBY, NC 28152

LOCATION 21 S, (R) PERTH RD, (R) STATE PARK, (R) HICKS CREEK ≈ 2 miles on rt AT BOX # 191, way off RD

SUBDIVISION _____ BLOCK / SECTION _____ LOT _____ LOT AREA 6.159 SITE CLASS. PS DESIGN FLOW 360 L.T.A.R. .5

Septic Tank: 1000 Gallons; STB 822 Date 4-11-02

Pump Tank: _____ Gallons; PT _____ Date _____

Pump Make: _____ Model _____ Serial No. _____

Nitrification Field: No Fields / Square Feet EQ=1200' Linear Feet 300'

No Lines 3X100' Trench Width 36" Max Trench Bottom Depth 36" Gravel Depth N/A

☒ New System ☐ Repair System Type: I, II, (III), IV, V, VI

System Description: GRAV 25% RED

Repair System Description: SAME

Maintenance Agreement Required: ☐ Yes ☒ No

☒ House/Mod. Home ☐ Mobile Home ☐ Business ☐ Other

No. Bedrooms 3 No. Bathrooms 2.5 No. Employees ____


☐ Slab ☒ Crawl Space ☐ Basement w/plumbing ☐ Basement wo/plumbing

Water Supply: ☒ Individual ☐ Public ☐ Community

WELL


Comments:/Conditions: (1) INSTALL LINES ON CONTOURS (2) MAINTAIN SETBACKS (3) USE 3 DROP BOXES (4) INSTALLER MUST BE AUTHORIZED IN IREDELL CO. B-4 OP CAN BE SIGNED OFF ON. (5) KEEP

"NOT TO SCALE" INITIAL SITE SKETCH

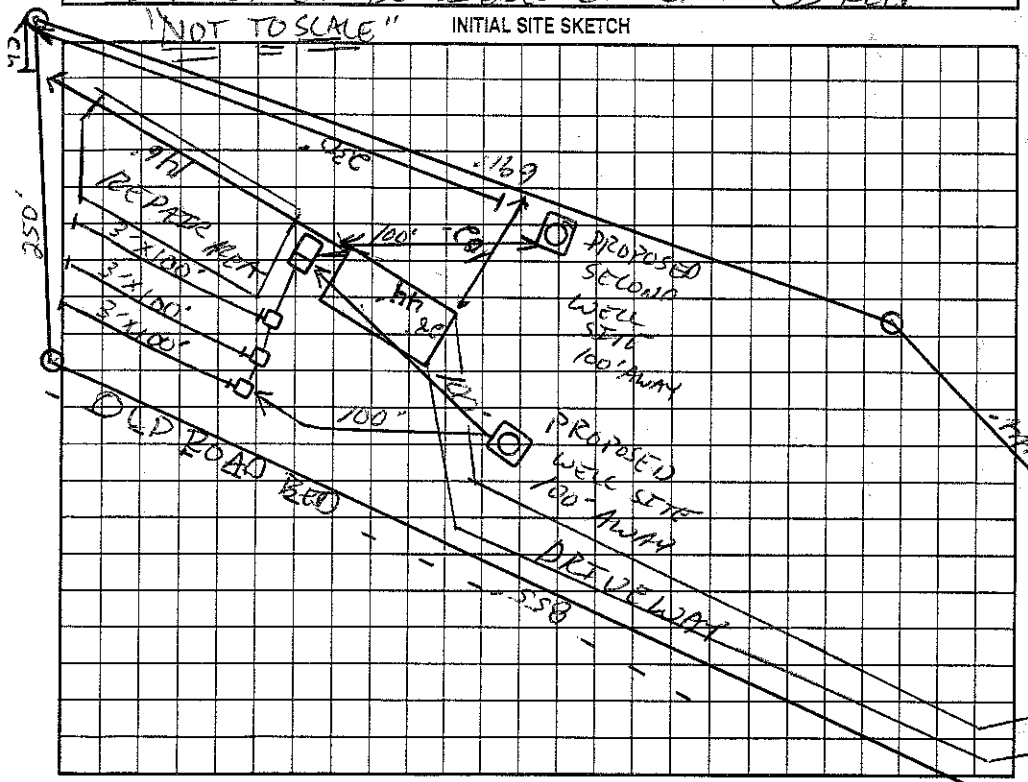

Comments:/Conditions: WELL OR WELLS 100' AWAY FROM ANY PART OF SYSTEM + REPAIR. LABEL FILTER + MARKER (N) INSTALLED 35% REDUCTION (X) → NEED OWNERS PERMISSION B-4 SIGNING OFF ON OP. GOT PERMISSION ON 5-28-03. LL

AS BUILT SKETCH

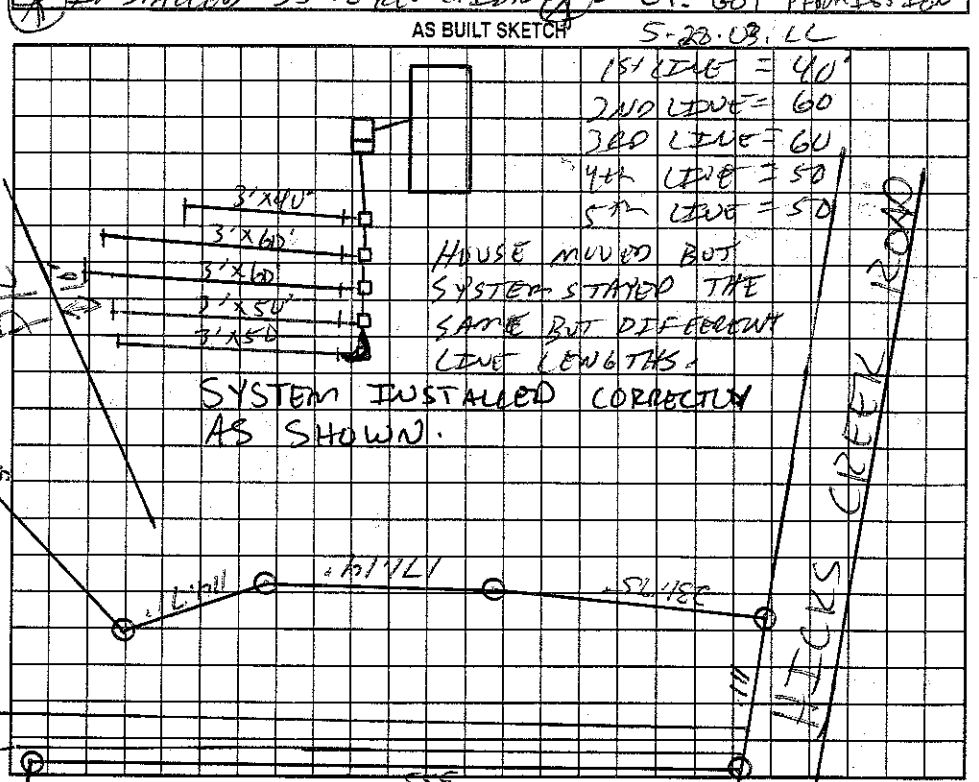

Permit can be suspended or revoked if any false information is supplied toward securing the permit/any unauthorized changes are made to the site/any unauthorized changes are made in the installation of the system. Improvement Permit with plat valid without expiration. Improvement Permit with site plan valid for sixty months. Authorization to Construct is valid for a period equal to that of Improvement Permit – not to exceed sixty months.

Signed: _____ date 4-15-03 Installed by: SUMNEY'S SEPTIC TANK

Improvement Permit by: _____ date 4-15-03 Operation Permit by: _____ date 5-28-03

Authorization to Construct by: _____ date 4-15-03 Existing System Inspection by: _____ date _____

HEALTH DEPT. COPY: WHITE OWNER COPY (FINAL): YELLOW OWNER COPY (INITIAL): PINK