IREDELL COUNTY HEALTH DEPARTMENT

STATESVILLE 704-878-5305 MOORESVILLE 704-664-5281

IMPROVEMENT PERMIT / AUTHORIZATION TO CONSTRUCT / OPERATION PERMIT / EXISTING SYSTEM INSPECTION

PERMIT# REPAIR PIN# 4721-92-0636 DATE 10-22-03

OWNER OR CONTRACTOR PATRICK P. COMINGS PHONE: Business 704-896-4615 Home 704-528-9694

ADDRESS 133 HICKS CREEK ROAD TROUTMAN, NC 28166

LOCATION OLD MOUNTAIN ROAD TO E. MONBO ROAD TL HICKS CREEK RD, 2ND HOUSE ON LEFT AT #133

SUBDIVISION ORCHARD ACRES BLOCK / SECTION ____ LOT 11 LOT AREA 1.5 SITE CLASS. ____ DESIGN FLOW 360 L.T.A.R. EXISTING

Septic Tank: EXISTING Gallons; STB ____ Date ____

Pump Tank: ____ Gallons; PT ____ Date ____

Pump Make: ____ Model ____ Serial No. ____

Nitrification Field: No Fields 1 Square Feet 300 Linear Feet 100

No Lines 1 Trench Width 36" Max Trench Bottom Depth 36"

☐ New System ☑ Repair System Type: I (II) III IV V VI

System Description: ____

Repair System Description: CONVENTIONAL, GRAVITY

Maintenance Agreement ~~Required~~: ☐ Yes ☑ No

Gravel Depth 18"

☑ House/Mod. Home No. Bedrooms 3

☐ Mobile Home No. Bathrooms 2

☐ Business No. Employees ____

☐ Other ____


☐ Slab ☑ Crawl Space ☐ Basement w/plumbing ☐ Basement wo/plumbing

Water Supply: ☑ Individual ☐ Public ☐ Community WELL

Comments:/Conditions: INSTALL NEW 3'x100' LINE AS SHOWN USING 18" STONE

Comments:/Conditions: THIS PERMIT SERVES AS "NOTICE OF VIOLATION" SYSTEM TO BE BROUGHT INTO COMPLIANCE BY NOVEMBER 24, 2003

INITIAL SITE SKETCH

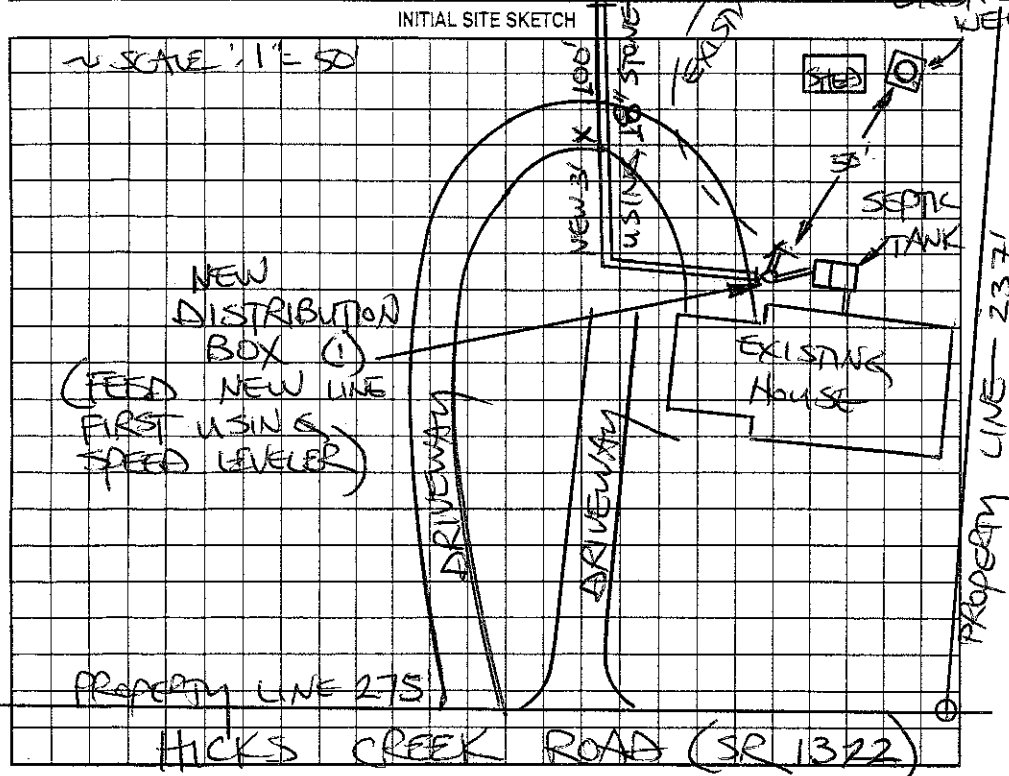

AS BUILT SKETCH

SYSTEM REPAIRED ACCORDING TO INITIAL SITE SKETCH

Permit can be suspended or revoked if any false information is supplied toward securing the permit/any unauthorized changes are made to the site/any unauthorized changes are made in the installation of the system. Improvement Permit with plat valid without expiration. Improvement Permit with site plan valid for sixty months. Authorization to Construct is valid for a period equal to that of Improvement Permit – not to exceed sixty months.

Signed: Patrick Comings date ____ Installed by: WES LYTTON

Improvement Permit by: STEVE HEDRICK date 10-22-03 Operation Permit by: STEVE HEDRICK date 12-12-03

Authorization to Construct by: STEVE HEDRICK date 10-22-03 Existing System Inspection by: ____ date ____

HEALTH DEPT. COPY: WHITE OWNER COPY (FINAL): YELLOW OWNER COPY (INITIAL): PINK