52412

IREDELL COUNTY HEALTH DEPARTMENT

STATESVILLE 704-878-5305 MOORESVILLE 704-664-5281

IMPROVEMENT PERMIT / CERTIFICATE OF COMPLETION / OPERATION PERMIT / EXISTING SYSTEM INSPECTION

PROPERTY DESCRIPTION NO. 18803 DATE 8-1-94 TAX MAP NO. 3K-A-20 Watershed: ☐ Yes ☑ No

OWNER OR CONTRACTOR David Rankin PHONE: Business Home 528-3176

ADDRESS PO Box 1122 Trentman

LOCATION East Mocksville Rd To Tally St. Turn 3rd Drive To Rt.

SUBDIVISION BLOCK / SECTION LOT LOT AREA 51.12 acres SITE CLASS. PS DESIGN FLOW 240 L.T.A.R. .35

Septic Tank: 1000 Gallons; STB 794 Date 2-20-95
Pump Tank: Gallons; PT Date
Pump Make: Model Serial No.
Nitrification Field: No Fields 1 Square Feet 690 Linear Feet 230
No Lines 2 Trench Width 36" Max Trench Bottom Depth 36" Gravel Depth 12"

☑ New System ☐ Repair System Type: I, II, III, IV, V, VI
System Description: Conv. Gravity
Repair System Description: " "
Maintenance Agreement Required: ☐ Yes ☑ No
☐ Slab ☑ Crawl Space ☐ Basement w/plumbing ☐ Basement wo/plumbing


☑ House/Mod. Home No. Bedrooms 2
☐ Mobile Home No. Bathrooms 2
☐ Business No. Employees
☐ Other

Water Supply:
☑ Individual
☐ Community
☐ Public


Comments:

Comments: Upper line installed deeper than 36" to trench bottom (first 30' of upper line). No alternative to change system due to lack of area. 100% Repair eliminated in area where shown. Slate track so repair could be place in a different area. Keep water line 10' from any part of septic system.

INITIAL SITE SKETCH

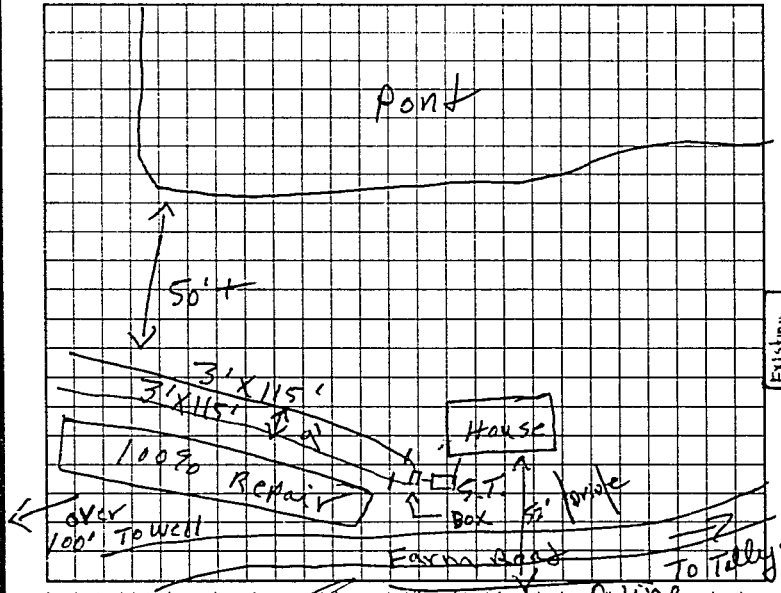

AS BUILT SKETCH

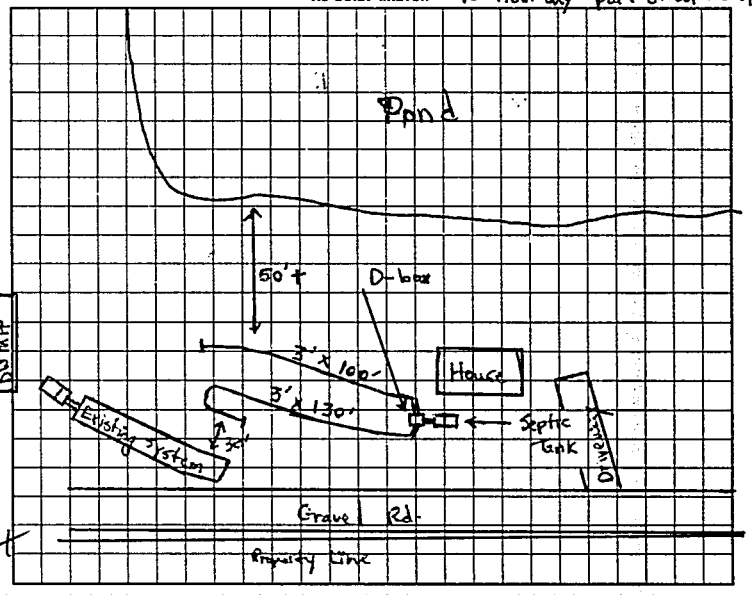

Existing DW Path

I understand that this permit can be suspended or revoked if any false information is supplied toward securing the permit/any unauthorized changes are made to the site/any unauthorized changes are made in the installation of the system. Improvement Permit is valid for 60 months from date of issuance.

Signed: X

Improvement Permit by: J. C. Moore date 8-1-94

Existing System Inspection by: date

Installed by: James Hudler

Certificate of Completion by: Michael P. Dennis date 4-24-95

Operation Permit by: date

HEALTH DEPT. COPY: WHITE INSPECTION COPY (FINAL): GREEN OWNER COPY (FINAL): YELLOW INSPECTION COPY (INITIAL): PINK OWNER COPY (INITIAL): GOLD

$5100