10:30

IREDELL COUNTY HEALTH DEPARTMENT

STATESVILLE 704-878-5305 MOORESVILLE 704-664-5281

IMPROVEMENT PERMIT / CERTIFICATE OF COMPLETION / OPERATION PERMIT / EXISTING SYSTEM INSPECTION

PROPERTY DESCRIPTION NO. ~~21146~~ ~~#126~~ DATE 7-27-95 TAX MAP NO. 3K-B-24 Watershed ☑ Yes ☐ No

OWNER OR CONTRACTOR Buford Payne Warren PHONE: Business Home 873 4848 WS4-PA

ADDRESS 749 New Sterling Ch Rd

LOCATION 21 S Stoney Point TR ~~East Monbo Rd~~ Oak mtn / To East monbo Rd 2 1/2 mi Rt

SUBDIVISION Warren Property BLOCK / SECTION ____ LOT 1 LOT AREA 1/2 acre SITE CLASS PS DESIGN FLOW 360 L.T.A.R. .3

Septic Tank: 1000 Gallons; STB 160 Date 7-7-95

Pump Tank: ____ Gallons; PT ____ Date ____

Pump Make: ____ Model ____ Serial No. ____

Nitrification Field: No Fields 1 Square Feet 900 Linear Feet 300

No Lines 3 Trench Width 36" Max Trench Bottom Depth 36-1 Gravel Depth N/A

☑ New System ☐ Repair System Type: I, II, III, IV, V, VI

System Description: Gravity Chamber System

Repair System Description: → LPP Infiltrator

Maintenance Agreement Required: ☐ Yes ☑ No

☐ House/Mod. Home No. Bedrooms 3

☐ Mobile Home No. Bathrooms 1

☐ Business No. Employees ____

☐ Other ____


☐ Slab ☐ Crawl Space ☐ Basement w/plumbing ☐ Basement wo/plumbing

Water Supply: ☑ Individual ☐ Community ☐ Public

Comments:

South →


INITIAL SITE SKETCH

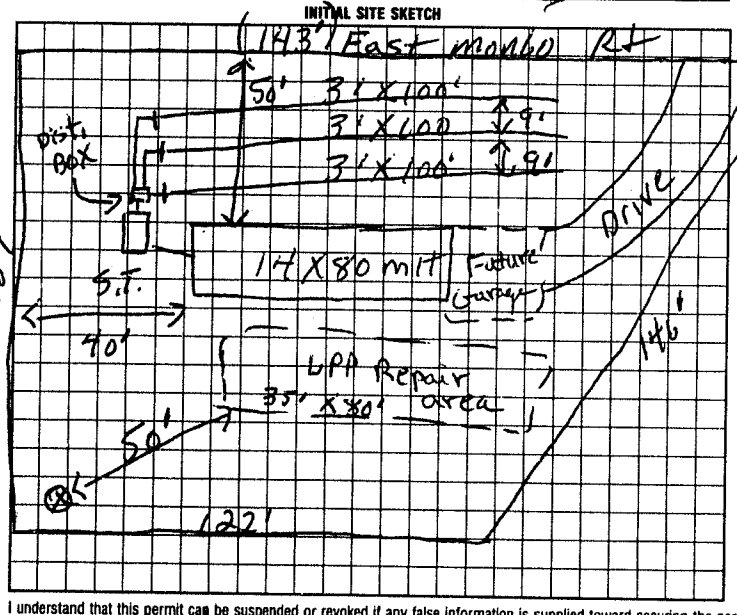

Comments:

E Monbo Road

AS BUILT SKETCH

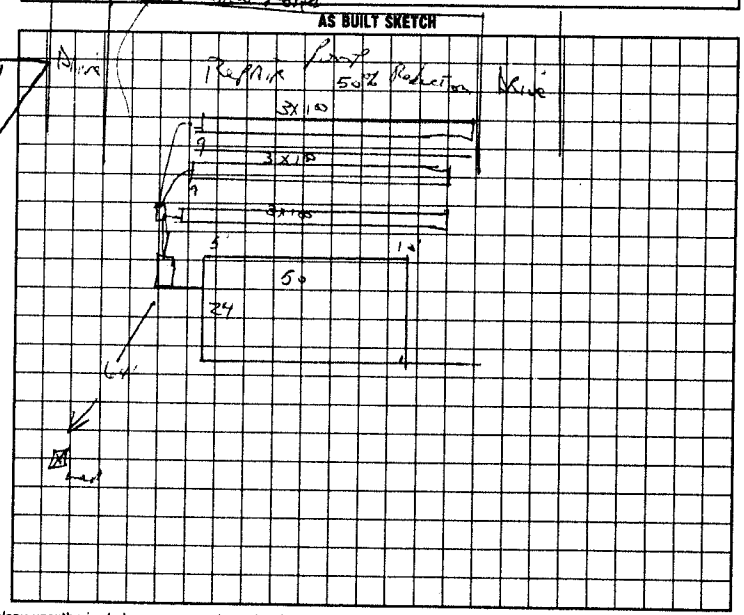

I understand that this permit can be suspended or revoked if any false information is supplied toward securing the permit/any unauthorized changes are made to the site/any unauthorized changes are made in the installation of the system. Improvement Permit is valid for 60 months from date of issuance.

Signed: X Buford Payne Warren

Improvement Permit by: B. C. Moore date 7-27-95

Existing System Inspection by: ____ date ____

Installed by: Huffman Surveying & Backhoe

Certificate of Completion by: [illegible] date 8-23-95

Operation Permit by: ____ date ____

HEALTH DEPT. COPY: WHITE INSPECTION COPY (FINAL): GREEN OWNER COPY (FINAL): YELLOW INSPECTION COPY (INITIAL): PINK OWNER COPY (INITIAL): GOLD