IREDELL COUNTY HEALTH DEPARTMENT

STATESVILLE 704-878-5305 MOORESVILLE 704-664-5281

IMPROVEMENT PERMIT / AUTHORIZATION TO CONSTRUCT / OPERATION PERMIT / EXISTING SYSTEM INSPECTION

PERMIT# 80731 PIN# 4721955180 DATE 4-28-99

OWNER OR CONTRACTOR Buford Warren PHONE: Business Home 873 4848

ADDRESS 749 New Sterling Rd Stony Pt.

LOCATION 215 TR OMR TL East Smonbo 1.7 Smi Rt.

SUBDIVISION HighGrove BLOCK / SECTION LOT 2 LOT AREA .58 acres SITE CLASS. PS DESIGN FLOW 360 L.T.A.R. .3

Septic Tank: 1000 Gallons; STB 1012 Date 5-1-98 | ☑ New System ☐ Repair System Type: I, II, III, IV, V, VI | ☑ House/Mod. Home No. Bedrooms 3 | Water Supply: ☑ Individual

Pump Tank: Gallons; PT Date | System Description: Gravity 25% Red. | ☐ Mobile Home No. Bathrooms 2 | ☐ Public

Pump Make: Model Serial No. | Repair System Description: " Pump | ☐ Business No. Employees | ☐ Community


Nitrification Field: No Fields 1 Square Feet 900 Linear Feet 300 | Maintenance Agreement Required: ☐ Yes ☑ No | ☐ Other

No Lines 4 Trench Width 36" Max Trench Bottom Depth 36" Gravel Depth N/A | ☐ Slab ☑ Crawl Space ☐ Basement w/plumbing ☐ Basement wo/plumbing


Comments/Conditions:

Comments/Conditions:

INITIAL SITE SKETCH

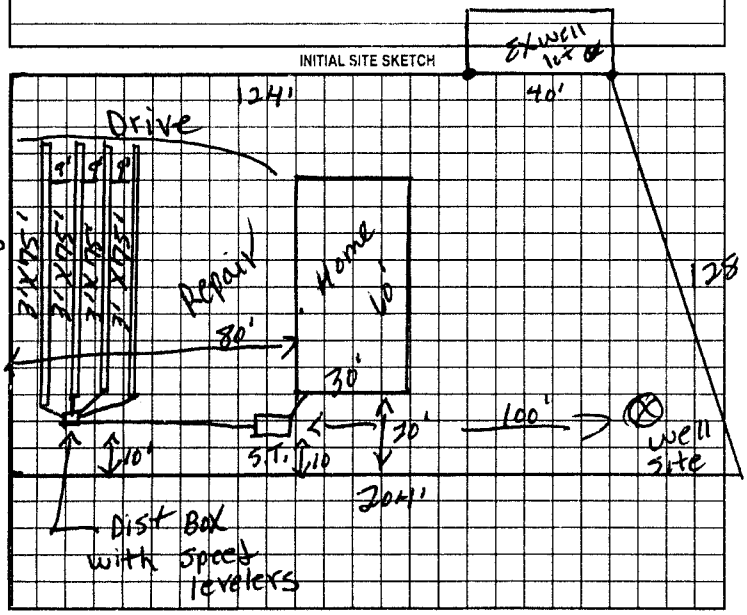

AS BUILT SKETCH

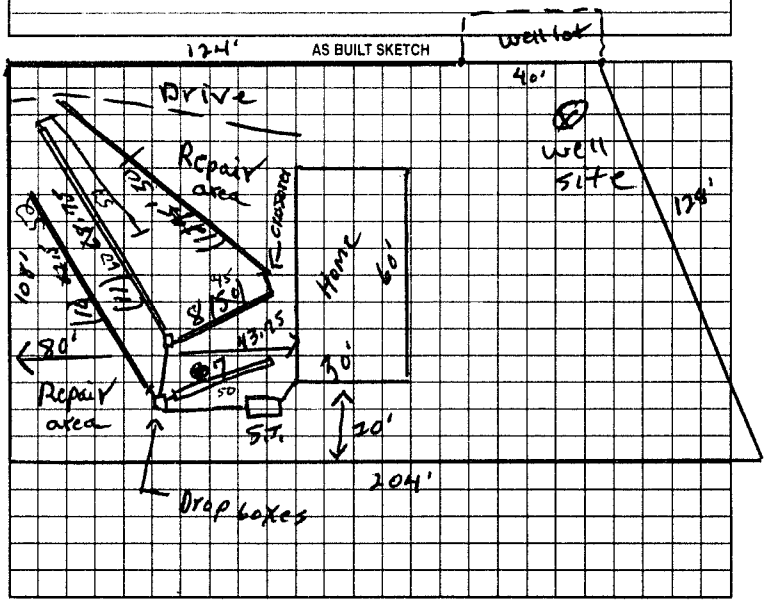

Permit can be suspended or revoked if any false information is supplied toward securing the permit/any unauthorized changes are made to the site/any unauthorized changes are made in the installation of the system. Improvement Permit with plat valid without expiration. Improvement Permit with site plan valid for sixty months. Authorization to Construct is valid for a period equal to that of Improvement Permit – not to exceed sixty months.

Signed: Buford Warren date 4-29-99 Installed by: A-1 Backhoe

Improvement Permit by: P.C. Moore date 4-28-99 Operation Permit by: P.C. Moore date 6-18-99

Authorization to Construct by: P.C. Moore date 4-28-99 Existing System Inspection by: date

HEALTH DEPT. COPY: WHITE OWNER COPY (FINAL): YELLOW OWNER COPY (INITIAL): PINK