IREDELL COUNTY HEALTH DEPARTMENT

STATESVILLE 704-878-5305 MOORESVILLE 704-664-5281

IMPROVEMENT PERMIT / AUTHORIZATION TO CONSTRUCT / OPERATION PERMIT / EXISTING SYSTEM INSPECTION

PERMIT# 80314 PIN# 4721 95 6201 DATE April 5 99

OWNER OR CONTRACTOR Mike STRAW PHONE: Business 663 3569 Home

ADDRESS 140-102 Cipola

LOCATION Old NC Rd (R) E Monbo on Right before Hicks Creek

SUBDIVISION High Grove BLOCK / SECTION LOT 3 LOT AREA 1.69 SITE CLASS. 15 DESIGN FLOW 360 L.T.A.R. .3

Septic Tank: 1000 Gallons: STB 1012 Date 5-1-99
Pump Tank: Gallons: PT Date
Pump Make: Model Serial No.
Nitrification Field: No Fields 1 Square Feet 1200 Linear Feet 300 25%
No Lines 5 Trench Width 36" Max Trench Bottom Depth 36" Gravel Depth 6" Sand

☒ New System ☐ Repair System Type: I, II, III, IV, V, VI
System Description: 25% Reduction
Repair System Description: Pump 25-50% Reduction
Maintenance Agreement Required: ☐ Yes ☒ No

☒ House/Mod. Home No. Bedrooms 3
☐ Mobile Home No. Bathrooms 2
☐ Business No. Employees
☐ Other


☐ Slab ☒ Crawl Space ☐ Basement w/plumbing ☐ Basement wo/plumbing

Water Supply: ☒ Individual ☐ Public ☐ Community WELL


Comments/Conditions: Keep Lines on Contour Locate Home To insure Initial System To be in front Pump/25% Red.a Repair Note drop Boxes Keep H2o Lines out of Repair Area. 150 Chambers or 30 HDS Systems

Comments/Conditions.

INITIAL SITE SKETCH

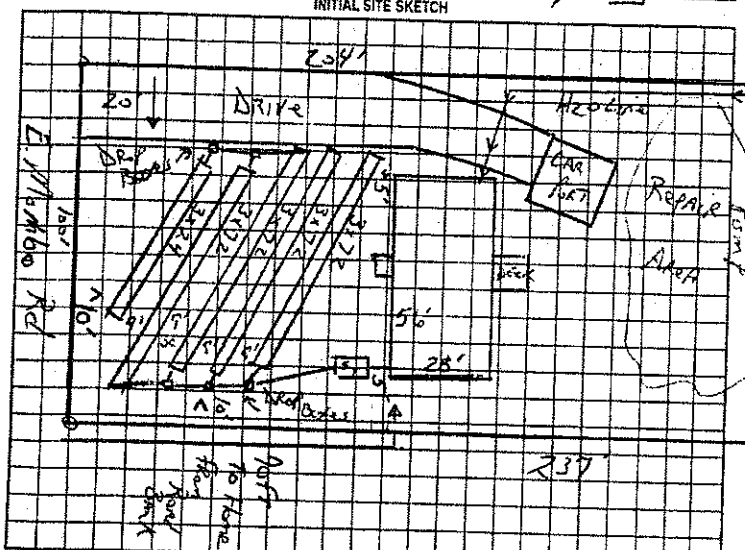

AS BUILT SKETCH

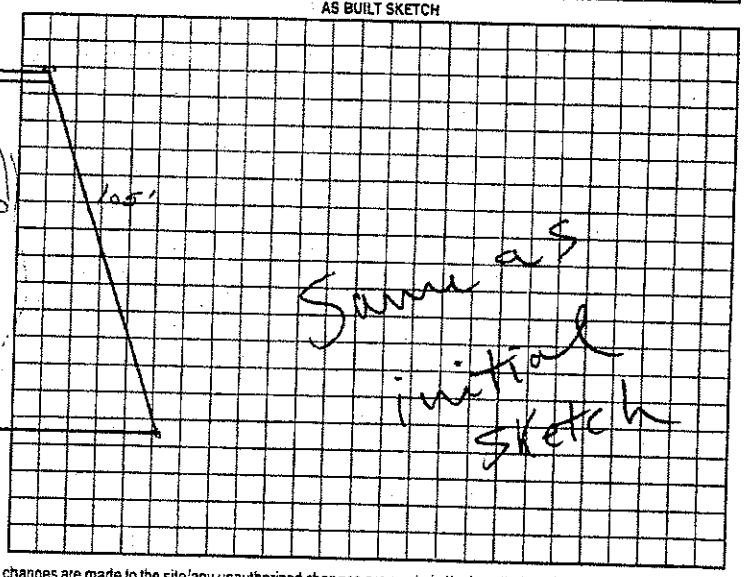

Permit can be suspended or revoked if any false information is supplied toward securing the permit/any unauthorized changes are made to the site/any unauthorized changes are made in the installation of the system. Improvement Permit with plat valid without expiration. Improvement Permit with site plan valid for sixty months. Authorization to Construct is valid for a period equal to that of Improvement Permit – not to exceed sixty months.

Signed: date 4/22/99 Installed by: A-1 Backhoe

Improvement Permit by: L. Fetter date 4-5-99 Operation Permit by: E-C. Moore date 6-16-99

Authorization to Construct by: L. Fetter date 4-5-99 Existing System Inspection by: date

HEALTH DEPT COPY: WHITE OWNER COPY (FINAL): YELLOW OWNER COPY (INITIAL): PINK