IREDELL COUNTY HEALTH DEPARTMENT

STATESVILLE 704-878-5305 MOORESVILLE 704-664-5281

IMPROVEMENT PERMIT / AUTHORIZATION TO CONSTRUCT / OPERATION PERMIT / EXISTING SYSTEM INSPECTION

PERMIT# 81268 PIN# 4721956450 DATE 12/13/00

OWNER OR CONTRACTOR Buford Warren PHONE: Business 875-4848 Home

ADDRESS 149 Sterling Rd Stony Point NC 28678

LOCATION Old Mtn, L E Mombo, 2 miles on Rt

SUBDIVISION High Grove BLOCK / SECTION LOT 5 LOT AREA .64 AC SITE CLASS PS DESIGN FLOW 360 L.T.A.R. 0.5

Septic Tank: 1000 Gallons; STB 825 Date 6-21-01
Pump Tank: Gallons; PT Date
Pump Make: Model Serial No.
Nitrification Field: No Fields 1 Square Feet 1200 Linear Feet 300
No Lines 4 @ 75' Trench Width 36" Max Trench Bottom Depth 36" Gravel Depth —

☒ New System ☐ Repair System Type: I, II, (III), IV, V, VI
System Description: Gravity 25% Reduc
Repair System Description: PPBS
Maintenance Agreement Required: ☐ Yes ☒ No


☒ House/Mod. Home ☐ Mobile Home ☐ Business ☐ Other
No. Bedrooms 3 No. Bathrooms 2 No. Employees
☐ Slab ☒ Crawl Space ☐ Basement w/plumbing ☐ Basement wo/plumbing

Water Supply: ☒ Individual ☐ Public ☐ Community

Comments:/Conditions:


Comments:/Conditions: SEPTIC TANK WITH MARKER INSTALLED USING "POLYLOK" FILTER

INITIAL SITE SKETCH

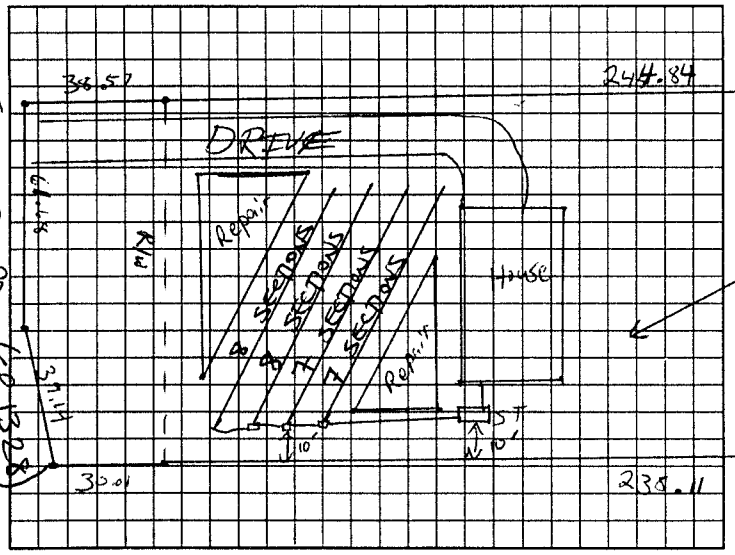

AS BUILT SKETCH

SYSTEM INSTALLED USING 30 HDS SECTIONS ACCORDING TO INITIAL SITE SKETCH.

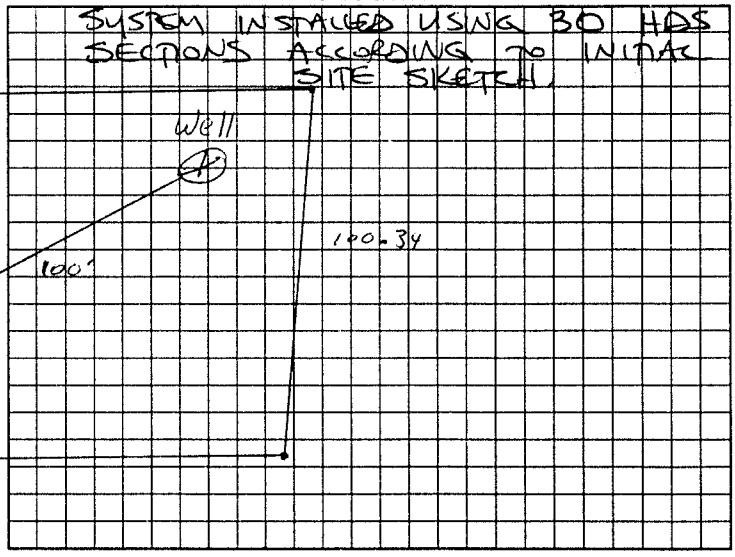

Permit can be suspended or revoked if any false information is supplied toward securing the permit/any unauthorized changes are made to the site/any unauthorized changes are made in the installation of the system. Improvement Permit with plat valid without expiration. Improvement Permit with site plan valid for sixty months. Authorization to Construct is valid for a period equal to that of Improvement Permit – not to exceed sixty months.

Signed: Buford Warren date 2.15.00 Installed by: Bob's Backhoe

Improvement Permit by: RSI date 12/13/00 Operation Permit by: Steve Hedrick date 9-13-01

Authorization to Construct by: RSI date 12/15/00 Existing System Inspection by: date

HEALTH DEPT. COPY: WHITE OWNER COPY (FINAL): YELLOW OWNER COPY (INITIAL): PINK