4:00

IREDELL COUNTY HEALTH DEPARTMENT - *ENVIRONMENTAL HEALTH* ☐ STATESVILLE OFFICE 704-878-5305 ☐ MOORESVILLE OFFICE 704-664-5281

IMPROVEMENT PERMIT / AUTHORIZATION TO CONSTRUCT / OPERATION PERMIT / EXISTING SYSTEM INSPECTION

PERMIT # 170374 PIN # 4721-97-6166 DATE FEBRUARY 15, 2012

OWNER JENNIFER BRINKLEY APPLICANT: SAME PHONE: Home/Cell # 704-528-4898 Business #

SITE ADDRESS 199 STONEGATE LANE OWNER / APPLICANT ADDRESS 199 STONEGATE LANE STATESVILLE, NC 28625

SITE DIRECTIONS OLD MOUNTAIN ROAD TO EAST MONBO ROAD, TR STONEGATE LANE, BEAR (L) AT STABLES

SUBDIVISION BLOCK / SECTION LOT # LOT AREA 73.87 ACRES DESIGN FLOW 240 L.T.A.R. 0.30 GPD/FT2

Septic Tank 1000 Gallons: STB 1000 Date 1-26-11 ☑ New System ☐ Repair ☐ Expansion System Type I (II) III IV V VI ☑ Residence No. Bedrooms 1 Water Supply ☑ Private WELLS

Pump Tank Gallons: P T Date System Description: CONVENTIONAL, GRAVITY ☐ Business No. Persons ☐ Public

Pump Make Model Serial # Repair System Description: CONVENTIONAL, GRAVITY ☐ Other No. Employees ☐ Community


No. Nitrification Fields: 1 No. Lines 3 Linear Feet 270 Maintenance Agreement Required ☐ YES ☒ NO ☑ Slab ☐ Crawl Space

Trench Width 36" Max. Trench Bottom Depth 36" Gravel Depth 12" ☑ GRAVITY ☐ PRESSURE ☐ Basement w/plumbing ☐ Basement w/o plumbing


Comments / Conditions: INSTALL NITRIFICATION LINES ON CONTOUR AS SHOWN USING SERIAL DISTRIBUTION © AN "ACCEPTED SYSTEM" MAY ALSO BE USED

Red Polylok Filters installed
2" PVC tank marker installed

INITIAL SITE SKETCH

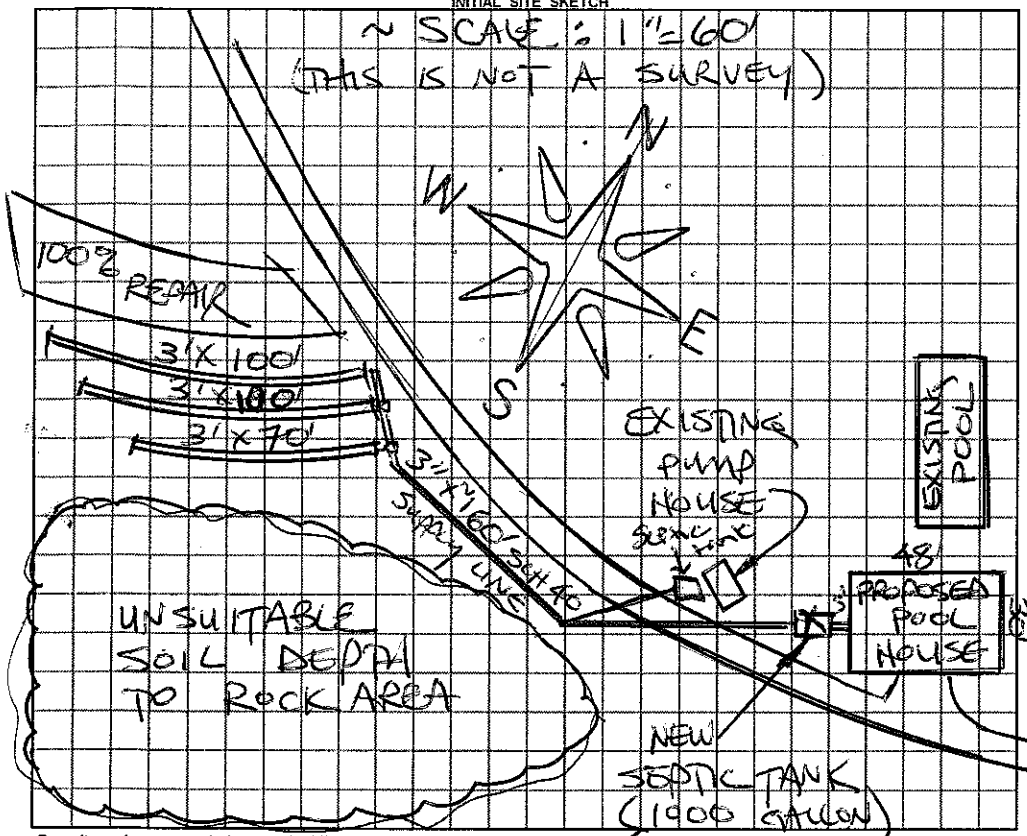

AS BUILT SKETCH

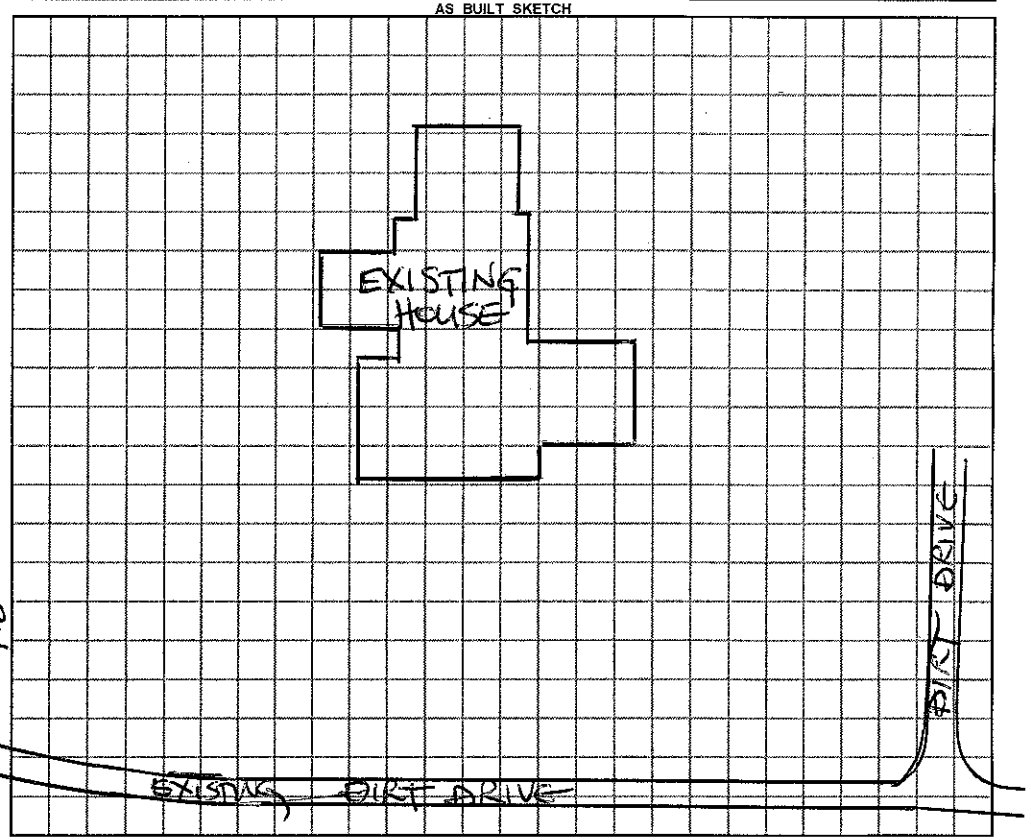

Permit can be suspended or revoked if any false information is supplied toward securing the permit / any unauthorized changes are made to the site / any unauthorized changes are made in the installation of the system.

☐ ***IMPROVEMENT PERMIT*** *with plat valid without expiration.* ☒ ***IMPROVEMENT PERMIT*** *with plat valid without expiration.* *site plan valid 60 mo.* ☑ ***AUTHORIZATION TO CONSTRUCT*** valid for period equal to IMPROVEMENT PERMIT--not to exceed 60 mo.

Owner / Applicant Signature: Jennifer Brinkley Date 2-16-12 Installed by: David Yountz

IMPROVEMENT PERMIT by: R. STEVE HENDRICK REHS Date 2-15-2012 OPERATION PERMIT by: Justin Henderson REHS Date 10-9-12

AUTHORIZATION TO CONSTRUCT by: R. STEVE HENDRICK REHS Date 2-15-2012 Existing System Inspected by: REHS Date

YOU SHOULD CONTACT A LOCATOR SERVICE PRIOR TO ANY EXCAVATION

White Copy -- Environmental Health YELLOW COPY (Final) Owner / Applicant PINK COPY (Initial) Owner / Applicant