IREDELL COUNTY HEALTH DEPARTMENT

STATESVILLE 704-878-5305 MOORESVILLE 704-664-5281

IMPROVEMENT PERMIT / CERTIFICATE OF COMPLETION / OPERATION PERMIT / EXISTING SYSTEM INSPECTION

PROPERTY DESCRIPTION NO. 68841 DATE 8-21-97 TAX MAP NO. 4721976166 Watershed: ☐ Yes ☐ No

OWNER OR CONTRACTOR Albert Schneider PHONE: Business Home 8739789

ADDRESS 324 Earlwood Rd Statesville, N.C.

LOCATION old main Rd To East monbo Tr Stonegate at end

SUBDIVISION BLOCK / SECTION LOT LOT AREA 13.37 acres SITE CLASS. 0/5 DESIGN FLOW 600 L.T.A.R. 1.3

Septic Tank: 1500 Gallons; STB 1997 Date 9-16-98 ☑ New System ☐ Repair System Type: I, II, III, IV, V, VI ☐ House/Mod. Home No. Bedrooms 5

Pump Tank: Gallons; PT Date ☐ Mobile Home No. Bathrooms 1.7

Pump Make: Model Serial No. System Description: Conv. Gravity/over 450 gal ☐ Business No. Employees

Nitrification Field: No Fields 1 Square Feet 2000 Linear Feet 666 Repair System Description: Pump TO Conv. Lines ☐ Other


No Lines 5 Trench Width 36" Max Trench Bottom Depth 24" Maintenance Agreement Required: ☐ Yes ☑ No Gravel Depth ☐ Slab ☐ Crawl Space ☑ Basement w/plumbing ☐ Basement wo/plumbing

Water Supply: ☑ Individual ☐ Community ☐ Public


Comments:

Comments: locate well at least 100' from S.T. System or Repair area

INITIAL SITE SKETCH

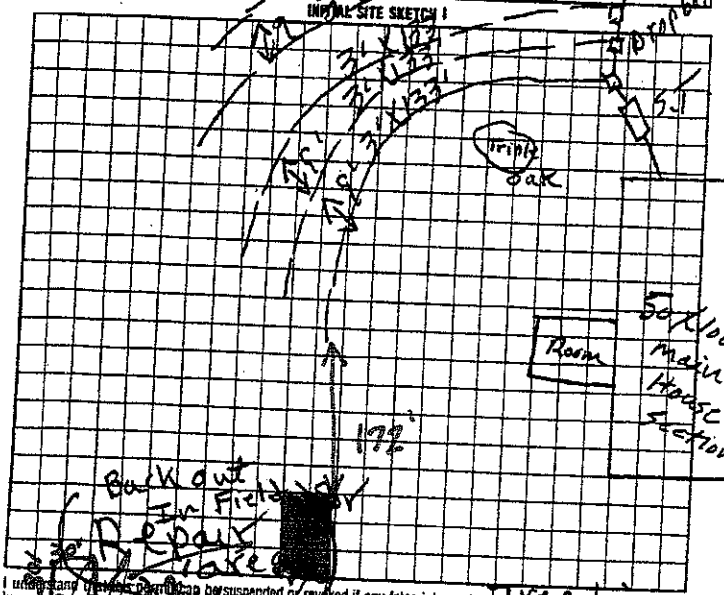

AS BUILT SKETCH

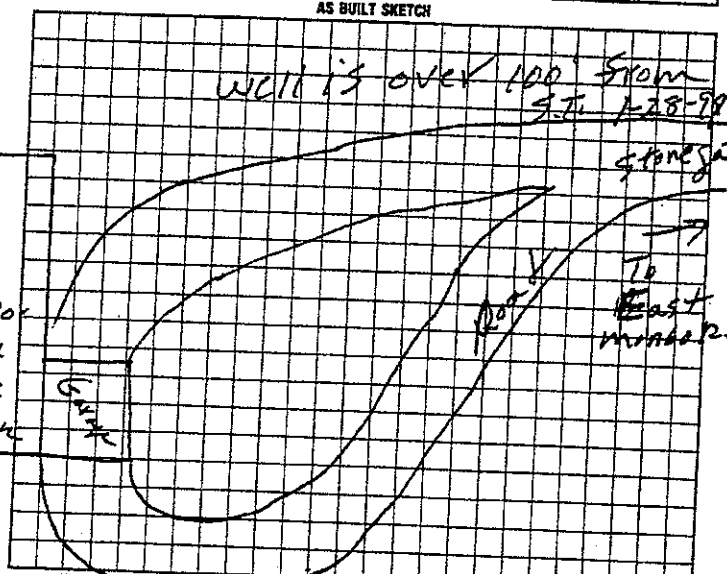

I understand the improvement permit may be suspended or revoked if any false information is supplied toward obtaining the permit/any unauthorized changes are made to the site/any unauthorized changes are made in the installation of the system. Improvement Permit is valid for 60 months from date of issuance.

Signed:

Improvement Permit by: R. C. Moore date 8-21-97 Installed by: WCS Fytton

Authorization to Occupy Existing Dwelling by: R. C. Moore date 8-21-97 Certificate of Completion by: date

Operation Permit by: R. C. Moore date 1-28-99

(HEALTH DEPT. COPY: WHITE) INSPECTION COPY (FINAL): GREEN OWNER COPY (FINAL): YELLOW INSPECTION COPY (INITIAL): PINK OWNER COPY (INITIAL): GOLD

to cover Authorization to Count Expires 60 mos from issue

Location of the proposed Pool maintain shed addition does not appear to impact the existing on-site septic system.**NOTE: No domestic plumbing

REHS

Date: 7-12-11

ICHD-Environmental Health Division