IREDELL COUNTY HEALTH DEPARTMENT

STATESVILLE 704-878-5305 MOORESVILLE 704-664-5281

IMPROVEMENT PERMIT / AUTHORIZATION TO CONSTRUCT / OPERATION PERMIT / EXISTING SYSTEM INSPECTION

PERMIT# 13039 PIN# 4722658713 DATE 9-23-05

OWNER OR CONTRACTOR Roger C Abell PHONE: Business 704-875-2888 Home

ADDRESS 10600 Texas RD Huntersville NC 28078

LOCATION Thom Rd — Buffalo Shoals RD Dawn Road 1.5 miles on left typical gravel road

SUBDIVISION BLOCK / SECTION LOT LOT AREA 4.86 AC SITE CLASS. PS DESIGN FLOW 480 L.T.A.R. .25

Septic Tank: 1000 Gallons; STB 1012 Date 8-2-05

Pump Tank: Gallons; PT Date

Pump Make: Model Serial No.

Nitrification Field: No Fields Square Feet 1920 Linear Feet 640

No Lines 6 Trench Width 36" Max Trench Bottom Depth 36" Gravel Depth

☑ New System ☐ Repair System Type: I II III IV V VI

System Description: Conv Gravity

Repair System Description: Conv Gravity

Maintenance Agreement Required: ☐ Yes ☑ No

☑ House/Mod. Home No. Bedrooms 4

☐ Mobile Home No. Bathrooms

☐ Business No. Employees

☐ Other

☐ Slab ☑ Crawl Space ☐ Basement w/plumbing ☐ Basement wo/plumbing

Water Supply: ☑ Individual ☐ Public ☐ Community


Comments:/Conditions: Install on Contour
Maintain all setbacks

Comments:/Conditions:

~~ANR~~ to Scale

INITIAL SITE SKETCH

25% Reduction
480 Feet

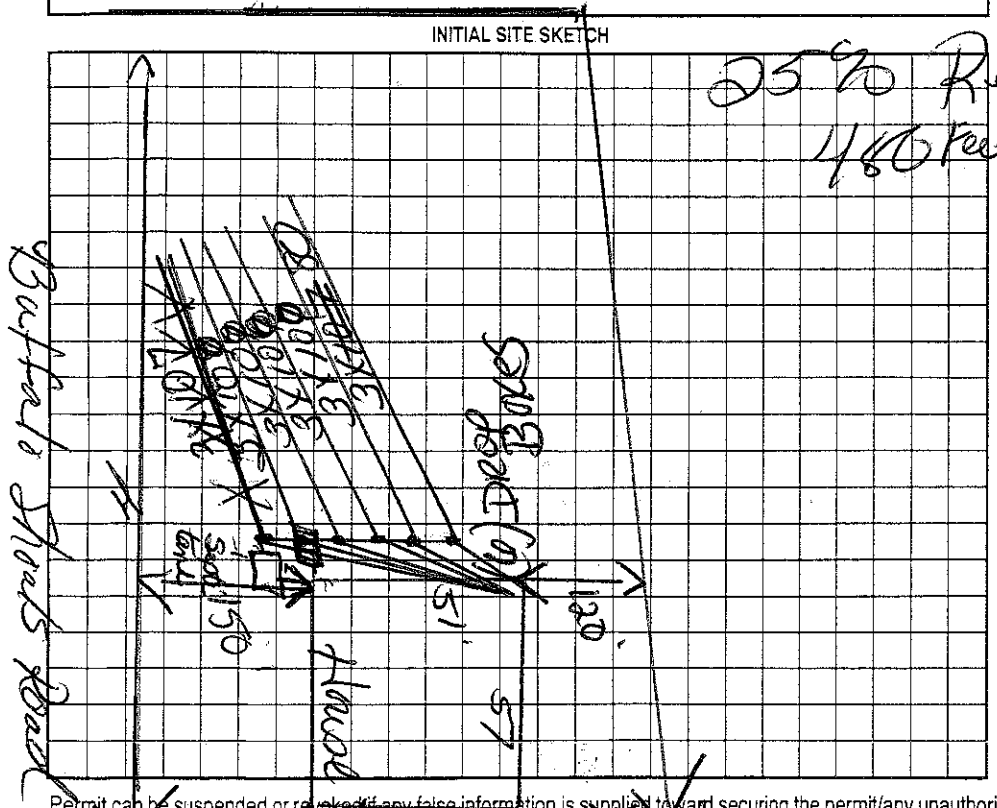

AS BUILT SKETCH

Permit can be suspended or revoked if any false information is supplied toward securing the permit/any unauthorized changes are made to the site/any unauthorized changes are made in the installation of the system. Improvement Permit will not valid without expiration. Improvement Permit will be valid for sixty months. Authorization to Construct is valid for a period equal to that of Improvement Permit – not to exceed sixty months.

Signed: date Installed by: David Yount

Improvement Permit by: Kelly Cook date 9-23-05 Operation Permit by: Kelly Cook date 3-28-06

Authorization to Construct by: Kelly Cook date 9-23-05 Existing System Inspection by: date

HEALTH DEPT. COPY: WHITE OWNER COPY (FINAL): YELLOW OWNER COPY (INITIAL): PINK