IREDELL COUNTY HEALTH DEPARTMENT

Statesville Office (704) 878-5305 Mooresville Office (704) 660-3625 PERMIT # 219739

IMPROVEMENT PERMIT / AUTHORIZATION TO CONSTRUCT / OPERATION PERMIT / EXISTING SYSTEM

PIN # 4722093914

APPLICANT: Crystal Danner Robinson APPLICANT ADDRESS: 207 Long Meadow Rd Mocksville NC

SITE ADDRESS: 1053 old Mountain Rd Statesville NC PHONE: 704-651-9591 ALT. PHONE: N/A

SITE DIRECTIONS: old Mtn Rd West off Kyles Crossroads

SUBDIVISION: N/A SECTION: N/A LOT # N/A LOT AREA: 1.77ac DESIGN FLOW: Ex L.T.A.R.: Ex

Septic Tank 1000 (gal) STB 160 Date 7-18-16
Pump Tank N/A (gal) PT N/A Date N/A
Pump Make N/A Model Bowlol Serial # P1168
Nitrification Fields Ex # Lines Ex Linear Ft: Ex
Trench Width Ex Max. Trench Bottom Depth Ex Gravel Depth


☐ New System ☒ Repair ☐ Expansion System Type: I ☒ II III IV V VI
System Description: Tank
Repair System Description:
Maintenance Agreement Required: ☐ YES ☒ NO
☒ GRAVITY ☐ PRESSURE

☒ Residence ☐ Business ☐ Other ☐ Slab ☐ Basement w/plumbing
No. Bedrooms Ex
No. Persons Ex
No. Employees
☐ Crawl Space
☒ Basement w/o plumbing


Water Supply: ☒ Private ☐ Public ☐ Community

Comments / Conditions: Pump crush & fill existing tank
maintain no greater than 6" of
cover or use risers

INITIAL SITE SKETCH

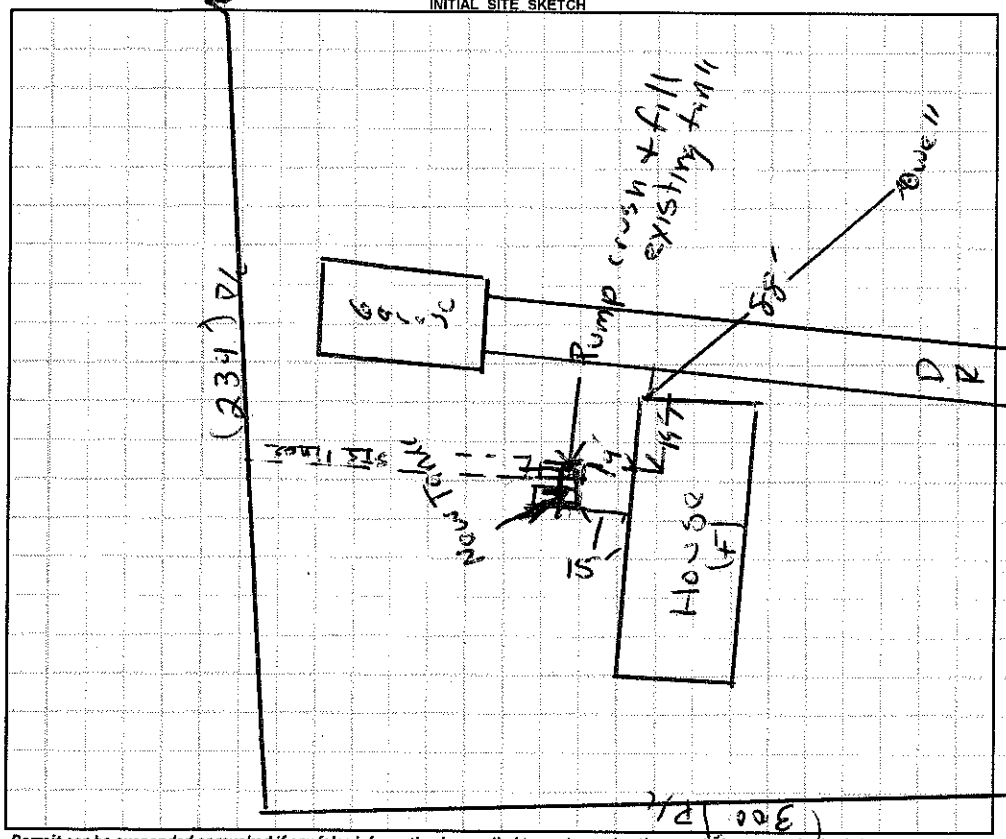

AS BUILT SKETCH

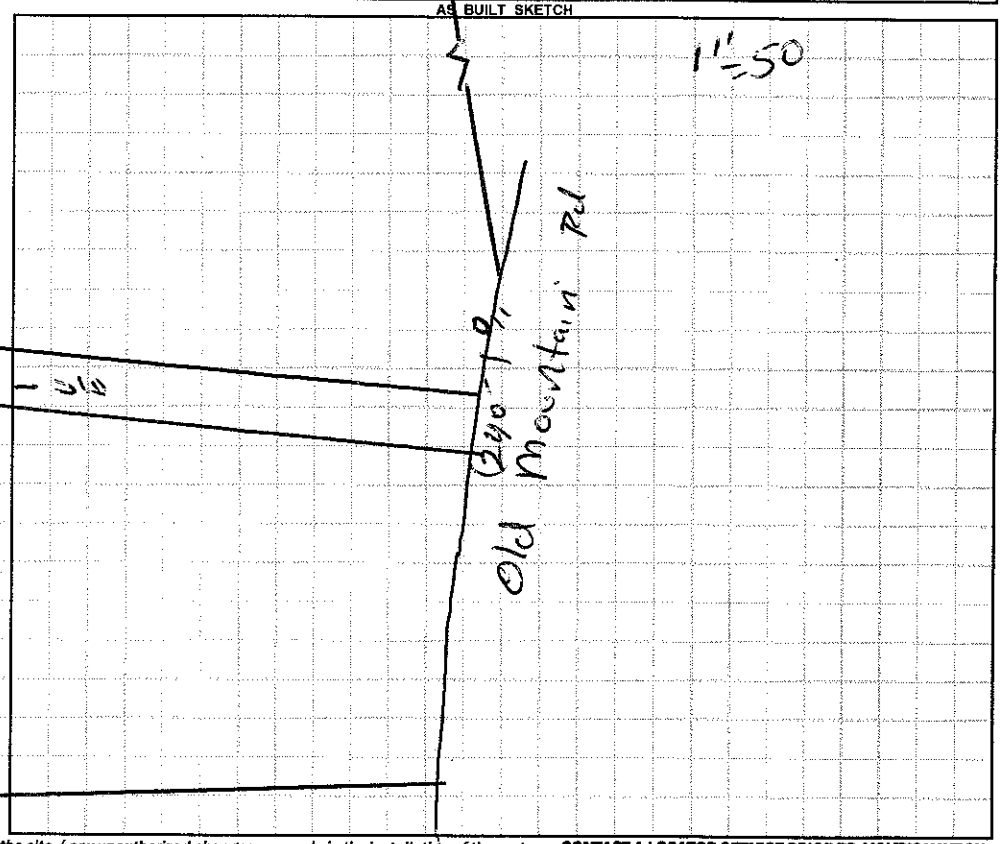

Permit can be suspended or revoked if any false information is supplied toward securing the permit / any unauthorized changes are made to the site / any unauthorized changes are made in the installation of the system. **CONTACT A LOCATOR SERVICE PRIOR TO ANY EXCAVATION**

☐ **IMPROVEMENT PERMIT** *with plat valid without expiration.* ☒ **IMPROVEMENT PERMIT** *with site plan valid for 60 mos.* ☒ **AUTHORIZATION TO CONSTRUCT** *valid for period equal to IMPROVEMENT PERMIT--not to exceed 60 mo.*

Owner / Applicant Signature: Crystal Danner Robinson Date: 6/27/16 Installed by: R + M Grading

IMPROVEMENT PERMIT by: Date: 06/27/16 OPERATION PERMIT by: Date: 06/28/16

AUTHORIZATION TO CONSTRUCT by: Date: 06/27/16 Existing System Inspected by: Date:

Health Dept. Copy - WHITE Applicant (Final Approval) - YELLOW Applicant (Conditional Approval) - PINK