IREDELL COUNTY HEALTH DEPARTMENT

STATESVILLE 704-878-5305 MOORESVILLE 704-664-528(0)

IMPROVEMENT PERMIT / AUTHORIZATION TO CONSTRUCT / OPERATION PERMIT / EXISTING SYSTEM INSPECTION

PERMIT # 160520 PIN # 4722167334 DATE 7-14-10

OWNER or APPLICANT Jack D Lewis PHONE: Business 704 431 3171 Home:

OWNER or APPLICANT ADDRESS 113 Dawnwood Rd

LOCATION / DIRECTIONS 215 (R) on Buffalo Shoals, (L) on Poppy

SUBDIVISION ~~Pt~~ Timbersbrook BLOCK / SECTION ~~Sec~~ LOT # 13 LOT AREA EX DESIGN FLOW EX L.T.A.R. EX

Septic Tank EX Gallons: STB Date

Pump Tank Gallons: P T Date

Pump Make Model Serial #

Nitrification Field No Fields 1 No Lines 3 Linear Feet EX

Trench Width EX Max. Trench Bottom Depth EX Gravel Depth EX ☒ GRAVITY ☐ PRESSURE

☐ New System ☐ Repair ☐ Expansion System Type I II III IV V VI

System Description: Existing

Repair System Description:

Maintenance Agreement Required ☐ YES ☒ NO

☒ Residence No. Bedrooms 3

☐ Business No. Persons

☐ Other No. Employees

☐ Slab ☐ Crawl Space

☒ Basement w/plumbing ☐ Basement w/o plumbing


Water Supply: ☐ Private ☒ Public ☐ Community

Comments / Conditions

Comments / Conditions

INITIAL SITE SKETCH

AS BUILT SKETCH

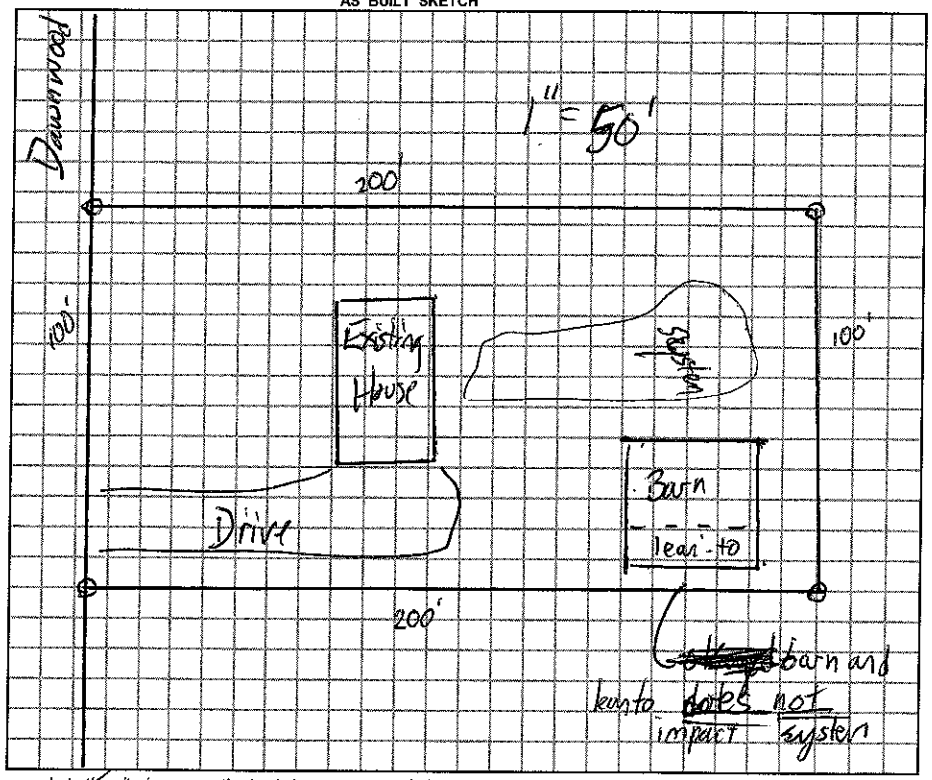

Permit can be suspended or revoked if any false information is supplied toward securing the permit / any unauthorized changes are made to the site / any unauthorized changes are made in the installation of the system.

☐ *IMPROVEMENT PERMIT w / plat valid without expiration.* ☒ *IMPROVEMENT PERMIT w / site plan valid for 60 mos.* ☒ *AUTHORIZATION TO CONSTRUCT valid for period equal to IMPROVEMENT PERMIT-not to exceed 60 mo.*

Owner / Applicant Signature: Jack D. Lewis Date 7-16-10

Improvement Permit by: Date

Authorzation to Construct by: Date

YOU SHOULD CONTACT A LOCATOR SERVICE PRIOR TO ANY EXCAVATION.

Installed by:

Operation Permit by: Date:

Existing System Inspected by: Date: 7-14-10

WHITE COPY Environmental Health YELLOW COPY (Final) Owner / Applicant PINK COPY (Initial) Owner / Applicant