54137

IREDELL COUNTY HEALTH DEPARTMENT

STATESVILLE 704-878-5305 MOORESVILLE 704-664-5281

IMPROVEMENT PERMIT / CERTIFICATE OF COMPLETION / OPERATION PERMIT / EXISTING SYSTEM INSPECTION

PROPERTY DESCRIPTION NO. 19977 DATE 1-4-95 TAX MAP NO. 35-3-D-4

OWNER OR CONTRACTOR Chris Davidson Watershed: ☐ Yes ☑ No

ADDRESS PO Box 5602 Sta. N.C. PHONE: Business ______ Home 528-6190

LOCATION Buffalo Shoals Rd Past Wilcox Roads 1/4 mi left

SUBDIVISION AF Treatment Est BLOCK / SECTION ______ LOT 47 LOT AREA 100'X222' SITE CLASS. PS DESIGN FLOW 240 L.T.A.R. .3

Septic Tank: 1000 Gallons; STB 1012 Date 11-29-94
Pump Tank: — Gallons; PT — Date —
Pump Make: — Model — Serial No. —
Nitrification Field: No Fields 1 Square Feet 810 Linear Feet 270
No Lines 3 Trench Width 36" Max Trench Bottom Depth 36" Gravel Depth 12"

☑ New System ☐ Repair System Type: I, (II), III, IV, V, VI
System Description: Conv. Gravity
Repair System Description: " "
Maintenance Agreement Required: ☐ Yes ☑ No

☑ House/Mod. Home ☐ Mobile Home ☐ Business ☐ Other ______
No. Bedrooms 2 No. Bathrooms 2 No. Employees ______


☐ Slab ☑ Crawl Space ☐ Basement w/plumbing ☐ Basement wo/plumbing

Water Supply: ☑ Individual ☐ Community ☐ Public

Comments:

Comments: Property lines not marked at time of inspection. System installed where it was flagged on initial layout.

INITIAL SITE SKETCH

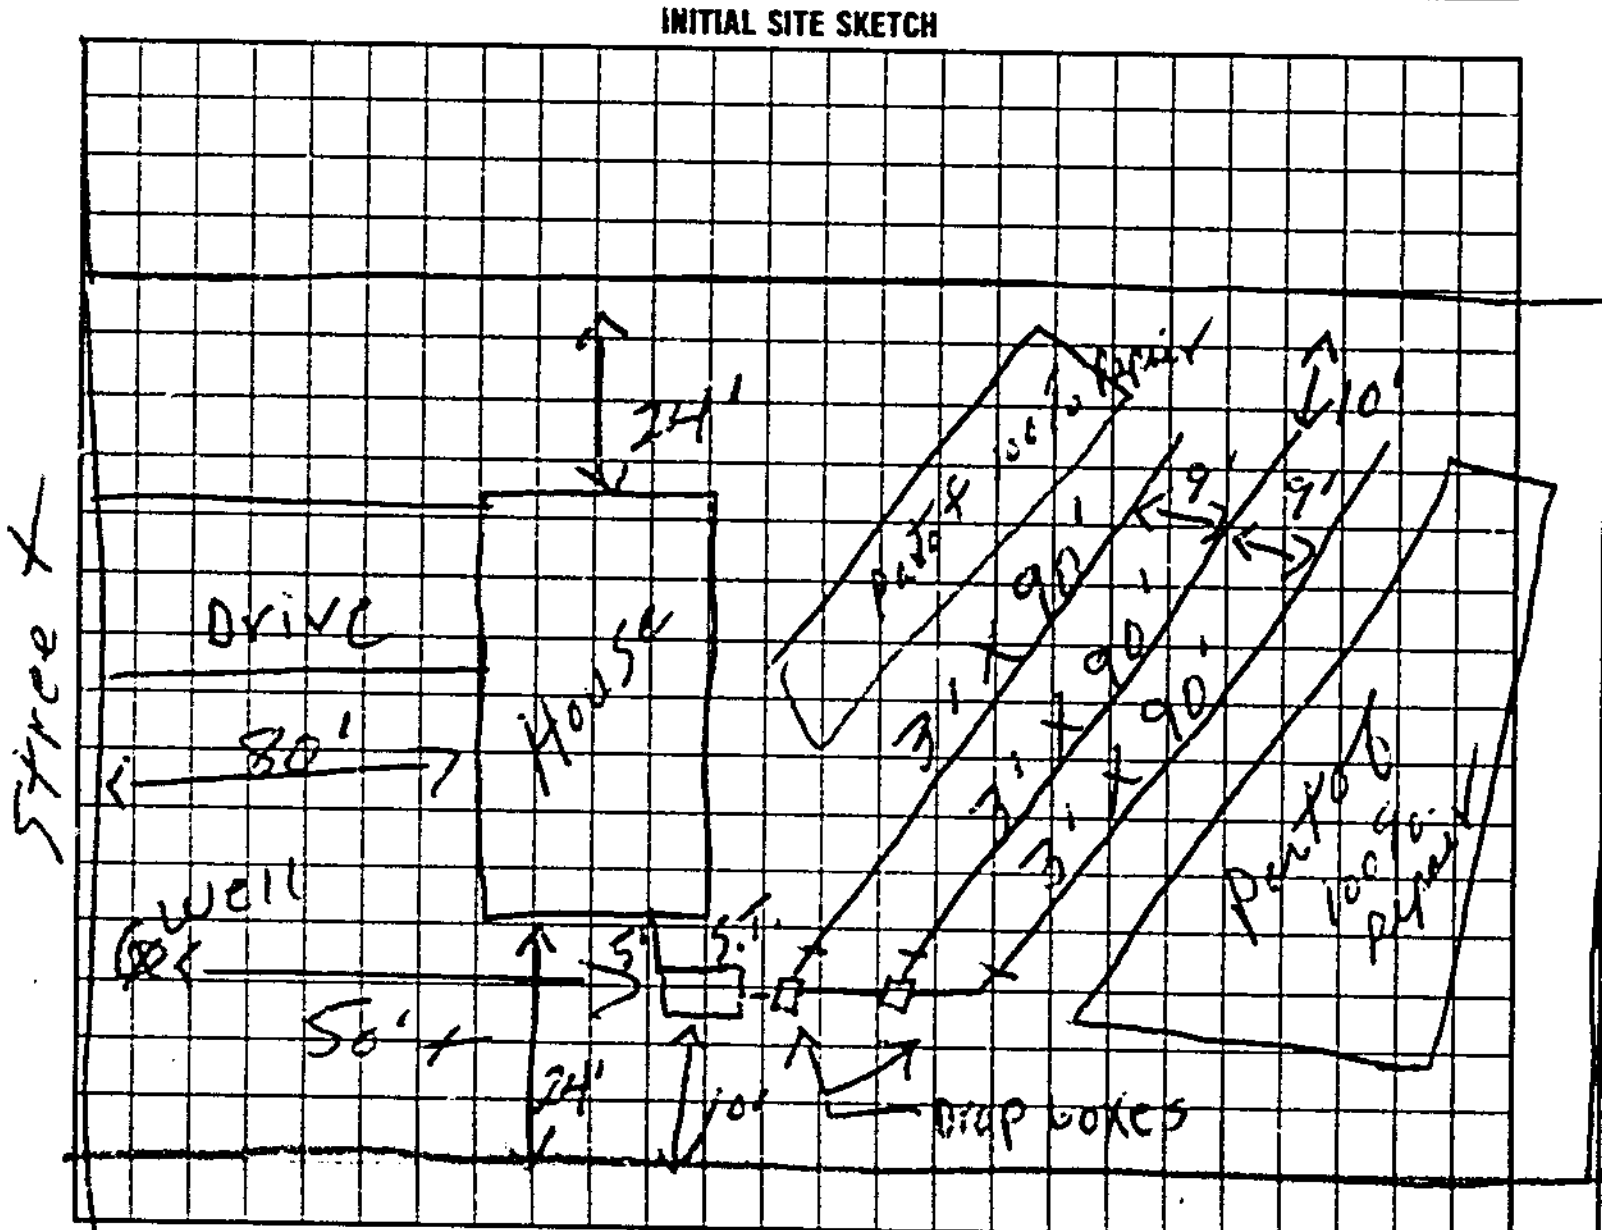

AS BUILT SKETCH

SAME AS INITIAL SKETCH

I understand that this permit can be suspended or revoked if any false information is supplied toward securing the permit/any unauthorized changes are made to the site/any unauthorized changes are made in the installation of the system. Improvement Permit is valid for 60 months from date of issuance.

Signed: x [signature]

Improvement Permit by: [signature] C. Moore date 1-4-95

Existing System Inspection by ______ date ______

Installed by: Forest Shuford

Certificate of Completion by: Michael J. Dennis date 3-16-95

Operation Permit by ______ date ______

HEALTH DEPT. COPY: WHITE INSPECTION COPY (FINAL): GREEN OWNER COPY (FINAL): YELLOW INSPECTION COPY (INITIAL): PINK OWNER COPY (INITIAL): GOLD

560000