IREDELL COUNTY HEALTH DEPARTMENT

Statesville Phone IR 3-7271 Mooresville Phone MO 3-1271

PERMIT TO INSTALL SEPTIC TANK

Permit NO. _____ Permit Date May 3 19 63

Owner E. Wayne Stewart Address Kyles X Rd.

Installed by C Hoke Address R 7


Location of Property our 1005 toward Oleste Henkle on left 2nd hs. past Kyles X Rd.

Tank	Capacity	Length of Lines	Fixtures
Block ( )	500 ( )	150' ( )	No. of Baths (1)
Precast (✓)	750 ( )	175' ( )	Dishwasher ( )
	1000 (✓)	200' ( )	Garbage Grdr. ( )
	1250 ( )	225' (✓)	Auto-Washer (✓)
	1500 ( )	250' ( )	Other _____
	Other _____	Other _____	

NOTIFY HEALTH DEPARTMENT AT LEAST EIGHT HOURS BEFORE TANK IS TO BE INSPECTED.

Final Inspection 5-3 19 63 Approved (✓) Disapproved ( )

Remarks well 60 ft.

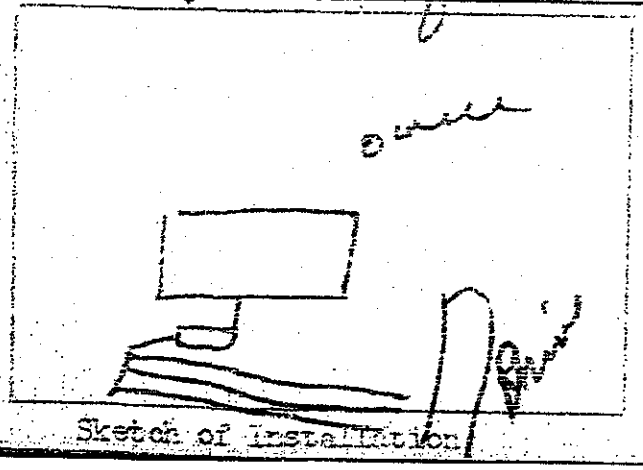

Sketch of Installation

Sanitarian

The proposed 16X18 DECK addition does not appear to impact the existing septic system.

**NOTE: DECK IN BACK SYSTEM IN FRONT

R.S.

Date: 2-6-09

ICHD-Environmental Health Division

JAN. 3, 1989 6:39