IREDELL COUNTY HEALTH DEPARTMENT

STATESVILLE 704-878-5305 MOORESVILLE 704-664-5281

IMPROVEMENT PERMIT / AUTHORIZATION TO CONSTRUCT / OPERATION PERMIT / EXISTING SYSTEM INSPECTION

PERMIT# 084355 PIN# 4722226589 (pt) DATE Sept. 14, 2000

OWNER OR CONTRACTOR Burt Tolley PHONE: Business 704-857-5859 Home

ADDRESS 430 Cooper Rd Salisbury, NC 28147 - Upright Grading & Septic

LOCATION Old Mill Road Turn on Cowan Rock Rd at end TR Idlebrook immediately TL Bradley Lane on left near/at end

SUBDIVISION Stonecrest BLOCK / SECTION LOT 17 LOT AREA .528 AC SITE CLASS RS DESIGN FLOW 360 gpd L.T.A.R. .25-.3

Septic Tank: 1000 Gallons; STB 312 Dellinger Date 7-24-00
Pump Tank: 1000 Gallons; PT 283 Dellinger Date 7-31-00
Pump Make: Model Zellar Serial No. N-140 B INF
Nitrification Field: No Fields 1 Square Feet 1020 Linear Feet 340
No Lines 4 Trench Width 36" Max Trench Bottom Depth 36"

☑ New System ☐ Repair System Type: I, II, III, IV, V, VI
System Description: PM - Innovative - 25% Red.
Repair System Description: LP Panel Black
Maintenance Agreement Required: ☐ Yes ☑ No
Gravel Depth N/A ☐ Slab ☑ Crawl Space ☐ Basement w/plumbing ☐ Basement wo/plumbing


☑ House/Mod. Home No. Bedrooms 3
☐ Mobile Home No. Bathrooms 2
☐ Business No. Employees
☐ Other

Water Supply: ☑ Individual ☐ Public ☐ Community

Comments/Conditions: SITE AREA Along left side & REAR of house WAS cut Necessitating Red Rank/Reapprt of septic system. Home Also located 10' Further off street Than Shown on ORIGINAL IP/AC. DRT

Comments/Conditions: Chief Hunter, PROS INSP, Head pump 9-27-00 NEED to check ALARM mounting, Elec hookup & tie WRAP on Risers

INITIAL SITE SKETCH

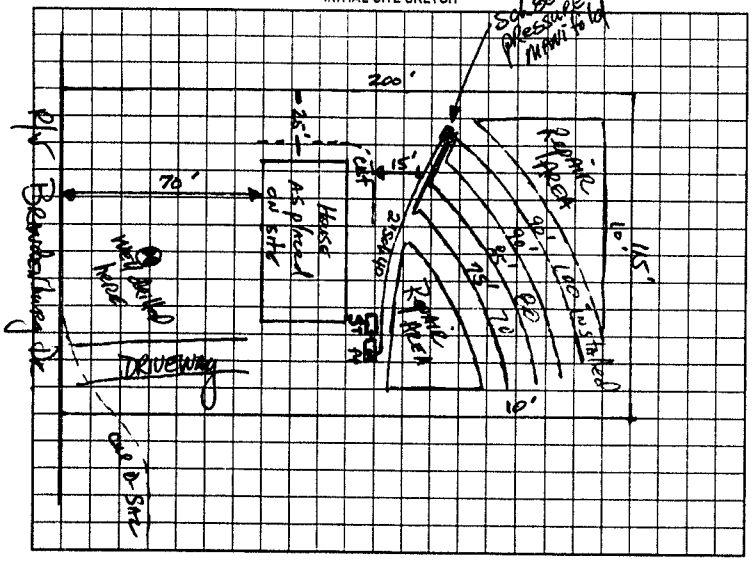

AS BUILT SKETCH

Permit can be suspended or revoked if any false information is supplied toward securing the permit/any unauthorized changes are made to the site/any unauthorized changes are made in the installation of the system. Improvement Permit with plat valid without expiration. Improvement Permit with site plan valid for sixty months. Authorization to Construct is valid for a period equal to that of Improvement Permit – not to exceed sixty months.

Signed: Rhonda Upright date 9-15-00 Installed by: Upright Grading & Septic

Improvement Permit by: date 9-14-00 Operation Permit by: RSE date 11/30/00

Authorization to Construct by: IRE date 9-14-00 Existing System Inspection by: date

HEALTH DEPT. COPY: WHITE OWNER COPY (FINAL): YELLOW OWNER COPY (INITIAL): PINK