IREDELL COUNTY HEALTH DEPARTMENT

STATESVILLE 704-878-5305 MOORESVILLE 704-664-5281

IMPROVEMENT PERMIT / AUTHORIZATION TO CONSTRUCT / OPERATION PERMIT / EXISTING SYSTEM INSPECTION

PERMIT# 0843549 PIN# 4722226589(pt) DATE Nov. 15, '99

OWNER OR CONTRACTOR Land Development Services PHONE: Business 528-6192 Home

ADDRESS PO Box 5602 Statesville

LOCATION 601 NW Road Turn on Compton Park Rd TR Elkbrook immediately TL Brandenburg ON left house ahead

SUBDIVISION Stonecrest @ Elkbrook BLOCK / SECTION LOT 116 LOT AREA .528 ac SITE CLASS PS DESIGN FLOW 360gpd D.T.A.R. .25-.3

Septic Tank: 1000 Gallons; STB 1012 Date 3-6-00
Pump Tank: Gallons; PT Date
Pump Make: Model Serial No.
Nitrification Field: No Fields 1 Square Feet 960± Linear Feet 320±
No Lines 4 @ 80± Trench Width 36" Max Trench Bottom Depth 36"

☑ New System ☐ Repair System Type: I. II. III. IV. V. VI
System Description: Gravity Innovative-25% Red.
Repair System Description: Gravel pumped Innovative-25% Red.
Maintenance Agreement Required: ☐ Yes ☑ No
Gravel Depth N/A

☑ House/Mod. Home No. Bedrooms 3
☐ Mobile Home No. Bathrooms 2
☐ Business No. Employees
☐ Other
☐ Slab ☑ Crawl Space ☐ Basement w/plumbing ☐ Basement wo/plumbing


Water Supply: ☑ Individual ☐ Public ☐ Community

Comments/Conditions: ~~K-one inspection port per lateral~~ JAP

Comments/Conditions: 52 chambers 13 chamber per Lines

1" = 50'

INITIAL SITE SKETCH

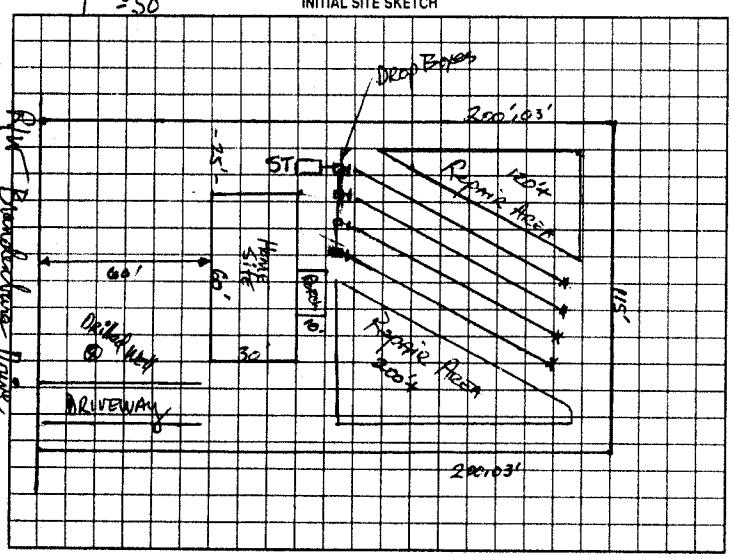

AS BUILT SKETCH

System Installed

As Designed

Permit can be suspended or revoked if any false information is supplied toward securing the permit/any unauthorized changes are made to the site/any unauthorized changes are made in the installation of the system. Improvement Permit with plat valid without expiration. Improvement Permit with site plan valid for sixty months. Authorization to Construct is valid for a period equal to that of Improvement Permit – not to exceed sixty months.

Signed: date 11/23/99 Installed by: D. Yountz & Son

Improvement Permit by: date 11-15-99 Operation Permit by: C Potter date May 10 2000

Authorization to Construct by: date 11-15-99 Existing System Inspection by: date

HEALTH DEPT COPY WHITE OWNER COPY (FINAL) YELLOW OWNER COPY (INITIAL) PINK