IREDELL COUNTY HEALTH DEPARTMENT

STATESVILLE 704-878-5305 MOORESVILLE 704-664-5281

IMPROVEMENT PERMIT / AUTHORIZATION TO CONSTRUCT / OPERATION PERMIT / EXISTING SYSTEM INSPECTION

PERMIT# 86689 PIN# 4722226589 DATE Jan 25 2000

OWNER OR CONTRACTOR Land Development Services PHONE: Business 528-6192 Home

ADDRESS Po Box 5602 Statesville

LOCATION Old MT Rd South (R) Compton PK (R) Idlebrook (L) Brandenburg Lot on Right

SUBDIVISION Stonecrest BLOCK / SECTION II LOT 23 LOT AREA .62 SITE CLASS PS DESIGN FLOW 360 L.T.A.R. .3

Septic Tank: 1000 Gallons; STB 1012 Date 5-29-00 ☒ New System ☐ Repair System Type: I. (II) III. IV. V. VI

Pump Tank: Gallons; PT Date System Description: GRAVITY Conventional

Pump Make: Model Serial No. Repair System Description: GRAVITY Reduction

Nitrification Field: No Fields 1 Square Feet 1200 Linear Feet 400 Maintenance Agreement Required: ☐ Yes ☒ No Pss. 6/a

No Lines 5 Trench Width 36" Max Trench Bottom Depth 36" Gravel Depth 12"

☐ House/Mod. Home ☒ Mobile Home ☐ Business ☐ Other

No. Bedrooms 3 No. Bathrooms 2 No. Employees


☐ Slab ☒ Crawl Space ☐ Basement w/plumbing ☐ Basement wo/plumbing

Water Supply: ☒ Individual ☐ Public ☐ Community WELL


Comments/Conditions: Locate well 100ft from septic system on MAX Feasible distance (50ft Min) 5 Drop boxes may use distribution box w/ ~~flow~~ Speed Levels

Comments/Conditions: SEPTIC TANK W/ RISERS INSTALLED USING "POLYLOK" FILTER

INITIAL SITE SKETCH Lot 23 1"x40' Scale

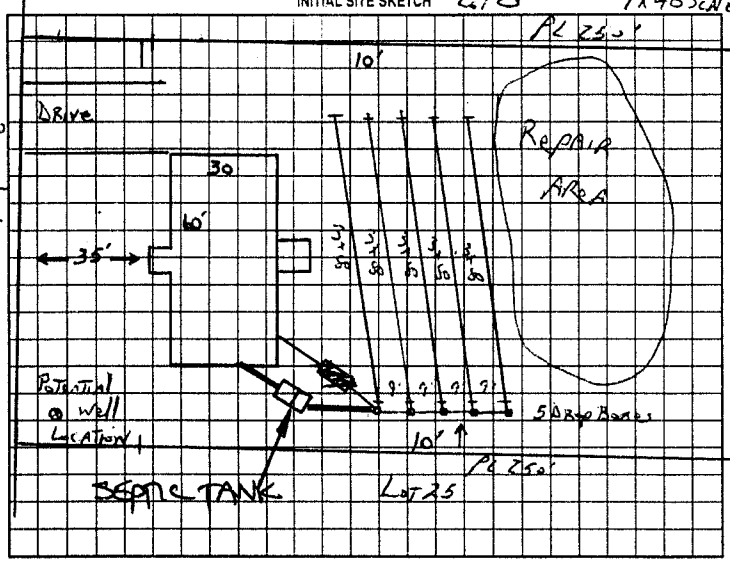

AS BUILT SKETCH

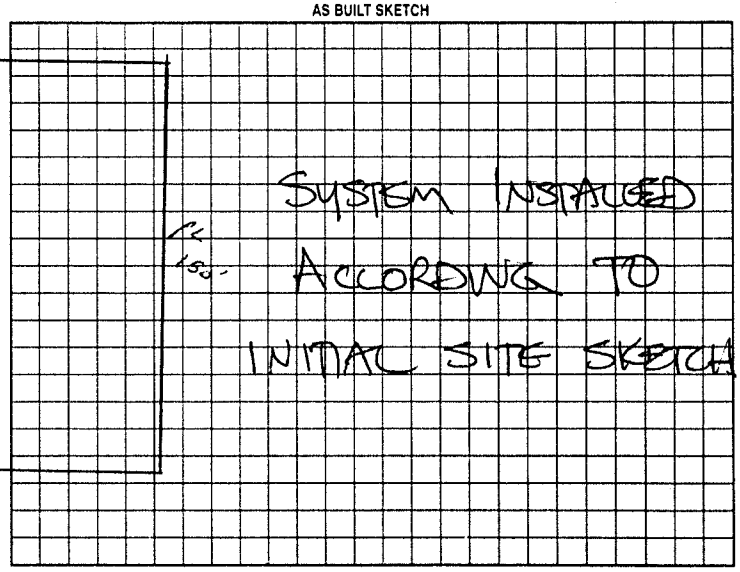

Permit can be suspended or revoked if any false information is supplied toward securing the permit/any unauthorized changes are made to the site/any unauthorized changes are made in the installation of the system. Improvement Permit with plat valid without expiration. Improvement Permit with site plan valid for sixty months. Authorization to Construct is valid for a period equal to that of Improvement Permit – not to exceed sixty months.

Signed: date Installed by: DAVID YOUNTZ

Improvement Permit by: JC Potter date Jan 25 2000 Operation Permit by: STEVE HENDRICK date 8-17-00

Authorization to Construct by: JC Potter date Jan 25 2000 Existing System Inspection by: date

HEALTH DEPT. COPY: WHITE OWNER COPY (FINAL): YELLOW OWNER COPY (INITIAL): PINK