11831.

IREDELL COUNTY HEALTH DEPARTMENT

(SEPTIC TANK) IMPROVEMENTS PERMIT AND CERTIFICATE OF COMPLETION

(Ground Absorption Sewage Disposal System -- G. S. Chapter 130-Article 13C)

OWNER OR CONTRACTOR James M. Hinson DATE 9-17-90 PERMIT NO. 35-5-A-26+27

PHONE: Business _____ Home _____

LOCATION Old Statesville Rd. south of Rubbo Xing - T.R. on Compton Park Rd. - T.R. on Maxwell Hosp. - 1st left.

SUBDIVISION NAME Compton Park LOT NO. 26+27 S. R. No. _____ SECTION OR BLOCK NO. _____


House ( ) Mobile Home (✓) Business ( ) Other _____

No. Bedrooms 3 No. Bathrooms 2

Garbage Disposal Unit Yes ( ) No (✓)
Auto. Dishwasher Yes (✓) No ( )
Auto. Wash. Machine Yes (✓) No ( )
Site Suitable Yes (✓) No ( )
Lot Area Acre.

Character & Porosity of Soil Loam - Suitable.
Percolation Rate 40 Min. per Inch
Topography 2 - 8% Slope
Depth to Water Table 10'+
Rock or other impervious formations Scattered rock.

_____ Basement with Plumbing _____ Basement without Plumbing ✓ No Basement

 

Size of Tank 1000 Gals.
Nitrification Field:
No. of Lines 3
Sq. Ft. 300 Lineal Ft. 300
Depth of Stone in Lines 12"
Water Supply: Individual (✓)
Public ( )

Plan of System

Installed by Dennis Gallimore

I understand and agree to install septic tank system as specified on this Improvements Permit.

Signed: _____

IMPROVEMENTS PERMIT BY Steve Brown

COMMENTS: _____

CERTIFICATE OF COMPLETION BY Steve Brown

EXISTING SYSTEM CHECKED BY: _____ DATE 9-17-90

CONSTRUCTION MUST COMPLY WITH ALL OTHER APPLICABLE STATE AND LOCAL REGULATIONS. DATE _____

Permit is VOID if any unauthorized changes are made in installation of system and/or if any false information is supplied in making Improvements Permit.

Health Dept. Copy: White Inspection Dept. Copy: Yellow Sanitarian's Copy: Pink Owner's Copy: Gold