IREDELL COUNTY HEALTH DEPARTMENT

STATESVILLE 704-878-5305 MOORESVILLE 704-664-5281 57214 ??

IMPROVEMENT PERMIT / CERTIFICATE OF COMPLETION / OPERATION PERMIT / EXISTING SYSTEM INSPECTION

PROPERTY DESCRIPTION NO. 21396 DATE 6-16-95 TAX MAP NO. 35-3-D-14 Watershed: ☒ Yes ☐ No WS IV PA

OWNER OR CONTRACTOR Chris Davidson PHONE: Business 528-6192 Home

ADDRESS PO Box 5602 Statesville, N.C.

LOCATION Buffalo Shoals Rd TL Poppy Lane at end TL 300' Lft

SUBDIVISION AE Trautman SEC. BLOCK / SECTION LOT 107B LOT AREA .65 acres SITE CLASS. PS DESIGN FLOW 240 L.T.A.R. 13

Septic Tank: 1000 Gallons; STB 794 Date 7-19-95

Pump Tank: Gallons: PT Date

Pump Make: Model Serial No.

Nitrification Field: No Fields 1 Square Feet 810 Linear Feet 270

No Lines 3 Trench Width 36" Max Trench Bottom Depth 36" Gravel Depth 12"

☒ New System ☐ Repair System Type: I ☒ II III, IV, V, VI

System Description: Conv. Gravity

Repair System Description: Installed

Maintenance Agreement Required: ☐ Yes ☒ No

☒ House/Mod. Home No. Bedrooms 2

☐ Mobile Home No. Bathrooms 2

☐ Business No. Employees

☐ Other


☐ Slab ☒ Crawl Space ☐ Basement w/plumbing ☐ Basement wo/plumbing

Water Supply: ☒ Individual ☐ Community ☐ Public


Comments:

Comments: well Not located at Time of This inspection

INITIAL SITE SKETCH

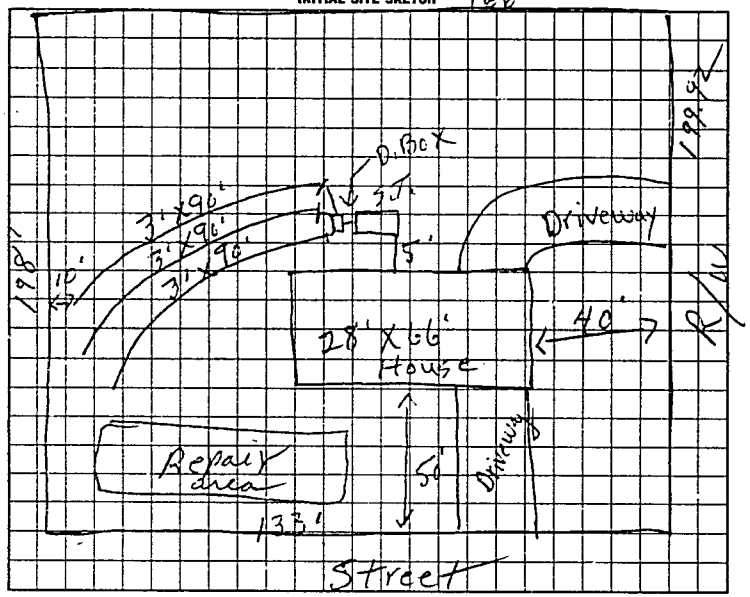

AS BUILT SKETCH

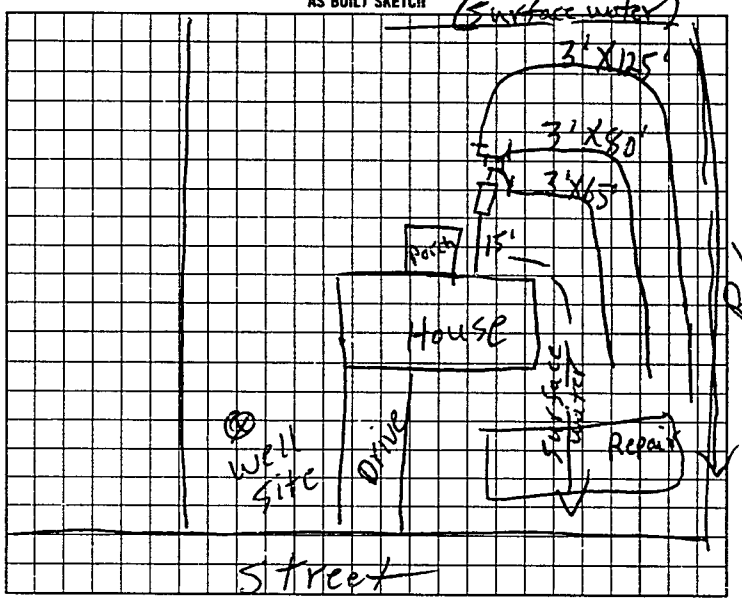

I understand that this permit can be suspended or revoked if any false information is supplied toward securing the permit/any unauthorized changes are made to the site/any unauthorized changes are made in the installation of the system. Improvement Permit is valid for 60 months from date of issuance.

Signed: X

Improvement Permit by: P.C. Moore date 6-16-95

Existing System Inspection by: date

Installed by: James Hutler

Certificate of Completion by: P.C. Moore date 9-19-95

Operation Permit by: date

HEALTH DEPT. COPY: WHITE INSPECTION COPY (FINAL): GREEN OWNER COPY (FINAL): YELLOW INSPECTION COPY (INITIAL): PINK OWNER COPY (INITIAL): GOLD